REMONUMENTATION

FEB 11 1998

SECTION

Approved by Menominee County
Land Survey Remonumentation
Peer Group Under Act 345 Of
P.A. Of 1990 On 10/31 199 7
Chairman

LAND CORNER RECORDATION CERTIFICATE
Filing Requirement of Act 74, Mich. P.A. 1970

For corners in

MENOMINEE
(County)

	Located In:		Corner Code #
1. Public Land Survey		T34N R 27W	E-10
		T___ R___	
		T___ R___	
		T___ R___	
2. Property Controlling	S___	T___ R___	
in Section	S___	T___ R___	
3. Miscellaneous	S___	T___ R___	
Property in Sec.	S___	T___ R___	

97 NOV 21 PM 3:20
Register of Deeds Stamp & File Number

4. Lot No. _____, Recorded Plat _____
5. Private Claims _____

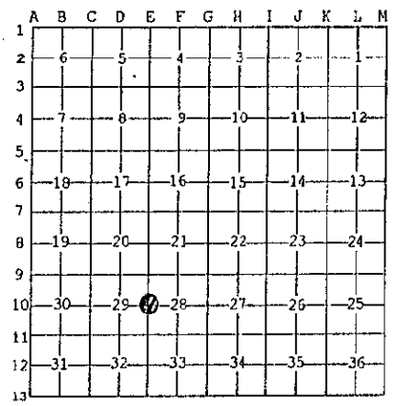

I, William Lenca, in a field survey on July 22, 19 97 do hereby state that under requirements of P.A. 74, Michigan P.A. of 1970, the corner points mentioned in lines 1 and 2 above were in conformance with regulations and rules therefore as required in the current manual of survey instructions of the United States Department of the Interior, Bureau of Land Management or by a decree of a Court of Law and /or that the corner points mentioned in lines 3, 4 and 5 above were in conformance with the rules of the Michigan Board of Land Surveyors or by a Decree of a Court of Law; established, re-established, monumented, recovered, found as expressed below:

NOTE: Not more than 2 corners, all in the same town and range, may be recorded on this certificate.

A. Description of original monument and accessories and/or subsequent restoration:

1848: Original Survey by James H. Mullett - B.T.'s - Y. Pine, 16" - S54°E - 21lks.; Y. Pine, 18" - N76°W - 30 lks. All original evidence for this corner has been destroyed by logging activities.

1980: L.C.R.C. No. 246 by George B. Wilson states "set 1/2" dia. iron pin, cap RLS 17607". TIES: Maple, 6" - N62°E - 48.7'; Maple, 8" - N80°E - 49.6'. Also shows partial Section Subdivision on back of L.C.R.C.

B. Description of corner evidence found and/or method applied in restoring or reestablishing corner:

We recovered a 1/2 inch diameter Iron Rod with a plastic cap marked RLS 17607 at an ancient fence corner per L.C.R.C. No. 246. Fences run North - South and West. We also found the 2 B.T.'s in position as described in L.C.R.C. No. 246. This position fits with Wilson's record measurments and with long standing lines of occupation, and is accepted as the best available evidence of the position of the original corner.

C. Description of monument for corner and accessories established to perpetuate locating the position of the corner:

STATE OF MICHIGAN
WILLIAM LENCA
LAND SURVEYOR
No. 26461
REGISTERED LAND SURVEYOR

Set 3/4" x 4' long aluminum rod/3-1/4" dia. Alum. cap stamped for corner:

12" dia. Oak	N20°E	46.17 feet	Scr. NBT
12" dia. Oak	N78°E	49.45 feet	Scr. NBT
16" dia. Oak	S02°E	91.42 feet	Scr. NBT
7" dia. Oak	N89°W	19.88 feet	Scr. NBT
Metal Survey Sign Post	N12°W	1.0 feet	

NOTE: All bearings are magnetic bearings. All distances are measured with steel tape. Distances to trees are to nail in side of tree.

Signed by William Lenca Date Oct. 07, 1997
Surveyor's Michigan License No. 26461

FORM APPROVED BY MICHIGAN STATE BOARD OF PROFESSIONAL SURVEYORS, JAN. 28, 1971
REVISED MAY 14,1975
REVISED JAN., 1983
REVISED OCT., 1995

550