

SURVEY & REMONUMENTATION

JUN 23 1994

COMMISSION

LAND CORNER RECORDATION CERTIFICATE Filing Requirement of Act 74, Mich. P.A. 1970

Approved by Menominee County
Land Survey Remonumentation
Fee Group Under Act 345 of

P.A. of 1990 Ch. 518 1994
Mike Davis
Chairman

For corners in
MENOMINEE

(County)

Located In:

Corner Code =#

1. Public Land Survey	T	34N	R	27W	E-12
	T		R		
	T		R		
	T		R		
2. Property Controlling in Section	S		T	R	
	S		T	R	
3. Miscellaneous Property in Sec.	S		T	R	
	S		T	R	

RECEIVED FOR RECORD
94 MAY 20 PM 3:3
PAGE # 66 BK 4
BARBARA MORRISON
REGISTER OF DEEDS
MENOMINEE, MI 49859
Register of Deeds Stamp & File Number

4. Lot No. _____, Recorded Plat _____
5. Private Claims _____

I, William Lenca, in a field survey on March 23, 1994, do hereby certify that under requirements of P.A. 74, Michigan P.A. of 1970, the corner points mentioned in lines 1 and 2 above were in conformance with regulations and rules therefore as required in the current manual of survey instructions of the United States Department of the Interior, Bureau of Land Management or by a decree of a Court of Law and/or that the corner points mentioned in lines 3, 4 and 5 above were in conformance with the rules of the Michigan Board of Land Surveyors or by a Decree of a Court of Law; established, re-established, monumented, re-monumented, recovered, found as expressed below:

A	B	C	D	E	F	G	H	I	J	K	L
2	6		5		4		3		2		1
3											
4	7		8		9		10		11		12
5											
6	13		17		16		15		14		13
7											
8	19		20		21		22		23		24
9											
10	30		29		28		27		26		25
11											
12	31		32		33		34		35		36
13											

NOTE: Not more than 4 corners, all in the same town and range, may be recorded on this certificate.

A. Description of original monument and accessories and/or subsequent restoration:


ORIGINAL B.T.'s: Aspen, 10", N20°W, 12 lks
Hemlock, 13", S18°E, 13 ks

Original Survey by James H. Mullett in 1848. All original evidence for this corner has been destroyed by wood harvesting activities.

PERPETUATION: This corner is shown in Certified Survey No. 362 by George B. Wilson, RLS No. 17607. The corner position is shown, however, no corner "monument" is shown or described. The corner is shown on line and midway between section corners.

B. Description of corner evidence found and/or method applied in restoring or reestablishing corner:

Corner position was established on line and midway between the Section Corners North and South as indicated in Certified Survey No. 362. This location has been used by Surveyors over the past 10 years, and is accepted as a careful and faithful reestablishment of the position of the original corner.

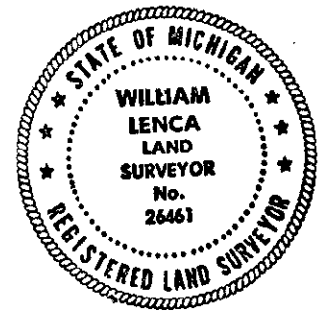

C. Description of monument for corner and accessories established to perpetuate locating the position of the corner:
Set 3/4" dia. Aluminum Rod 5' long/3-1/4" dia. cap stamped for corner:

10" dia. W. Ash	Scr. NBT	N24°E	10.09 feet
8" dia. W. Ash	Scr. NBT	S20°E	30.68 feet
6" dia. W. Ash	Scr. NBT	S40°W	34.50 feet
7" dia. Cedar	Scr. NBT	N57°W	29.03 feet
Carsonite		North	1.0 feet

NOTE: All bearings are magnetic bearings. All distances are measured with steel tape. Distances to trees are to nail in side of tree.

Signed by William Lenca Date April 22, 1994
Surveyor's Michigan License No. 26461