

SURVEY & REMONUMENTATION

JUN 23 1994

COMMISSION

LAND CORNER RECORDATION CERTIFICATE

Filing Requirement of Act 74, Mich. P.A. 1970

Approved by Menominee County
Land Survey Remonumentation
Peer Group Under Act 345 Of

P.A. of 1990 On 5/18 1994
McDavis
Chairman

For corners in
MENOMINEE
(County)

Located In: Corner Code -##

- | | | |
|------------------------------------|---------------------------|-------|
| 1. Public Land Survey | T <u>34N</u> R <u>27W</u> | E-13 |
| | T _____ R _____ | _____ |
| | T _____ R _____ | _____ |
| | T _____ R _____ | _____ |
| 2. Property Controlling in Section | S _____ T _____ R _____ | _____ |
| | S _____ T _____ R _____ | _____ |
| 3. Miscellaneous Property in Sec. | S _____ T _____ R _____ | _____ |
| | S _____ T _____ R _____ | _____ |

RECEIVED FOR RECORD
94 MAY 20 PM 3:31
PAGE # 67 BK 4
BARBARA MORRISON
REGISTER OF DEEDS
MENOMINEE, MI 49850
Register of Deeds Stamp & File Number

4. Lot No. _____, Recorded Plat _____
5. Private Claims _____

I, William Lenca, in a field survey on March 15, 1994, do hereby certify that under requirements of P.A. 74, Michigan P.A. of 1970, the corner points mentioned in lines 1 and 2 above were in conformance with regulations and rules therefore as required in the current manual of survey instructions of the United States Department of the Interior, Bureau of Land Management or by a decree of a Court of Law and/or that the corner points mentioned in lines 3, 4 and 5 above were in conformance with the rules of the Michigan Board of Land Surveyors or by a Decree of a Court of Law, established, re-established, monumented, re-monumented, recovered, found as expressed below:

NOTE: Not more than 4 corners, all in the same town and range, may be recorded on this certificate.

A. Description of original monument and accessories and/or subsequent restoration:

ORIGINAL B.T.'s: Beech, 10", N45°W, 29 lks
Beech, 8", N75°E, 32 lks


Original Survey by James H. Mullett in 1848. All original evidence for this corner has been destroyed by County Road improvements.

PERPETUATION: Certified Survey No. 362 as recorded by George B. Wilson, RLS No. 17607, in 1983 indicates that a 1/2 inch diameter iron rod was set for this corner position. The survey also shows a subdivision of Section 32 of T34N-R27W.

B. Description of corner evidence found and/or method applied in restoring or reestablishing corner:

A 1/2" diameter Iron Pin was found in the centerline of an East-West county road in line with an old fence line running South from this location. This position fits with the recorded distance (as shown in Certified Survey No. 362), and is accepted as the best available evidence for the position of the original corner.

A	B	C	D	E	F	G	H	I	J	K	L
2	6	5	4	3	2	1					
3											
4	7	8	9	10	11	12					
5											
6	18	17	16	15	14	13					
7											
8	19	20	21	22	23	24					
9											
10	30	29	28	27	26	25					
11											
12	31	32	33	34	35	36					
13											

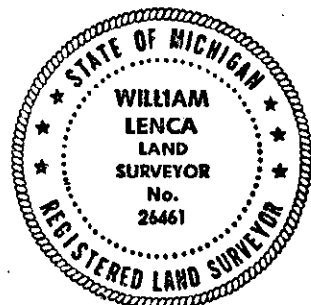

C. Description of monument for corner and accessories established to perpetuate locating the position of the corner:

Set 5/8" dia. Iron Rod/3-1/4" dia. Alum. cap stamped for corner location:

16" dia. W. Ash	Scr. NBT	N04°E	24.77 feet
16" dia. Maple	Scr. NBT	S30°E	57.52 feet
5/8" x 24" Iron Rod/2" Alum. cap marked "WITNESS MARKER"		S06°W	30.18 feet
5/8" x 24" Iron Rod/2" Alum. cap marked "WITNESS MARKER"		N60°E	51.72 feet
Survey Sign Post		South	30.5 feet

NOTE: All bearings are magnetic bearings. All distances are measured with steel tape. Distances to trees are to nail in side of tree.

Signed by William Lenca Date April 22, 1994
Surveyor's Michigan License No. 26461 April 22, 1994