

LAND CORNER RECORDATION CERTIFICATE
 Filing Requirement of Act 74, Mich. P.A. 1970

For corners in


<u>MENOMINEE</u> (County)	Located In:	Corner Code #
1. Public Land Survey	T <u>34</u> N R <u>27</u> W	<u>G03</u>
	T <u> </u> R <u> </u>	<u> </u>
	T <u> </u> R <u> </u>	<u> </u>
	T <u> </u> R <u> </u>	<u> </u>
2. Property Controlling in Section	S <u> </u> T <u> </u> R <u> </u>	<u> </u>
	S <u> </u> T <u> </u> R <u> </u>	<u> </u>
3. Miscellaneous Property in Sec.	S <u> </u> T <u> </u> R <u> </u>	<u> </u>
	S <u> </u> T <u> </u> R <u> </u>	<u> </u>

REGISTERED
 BARBARA MORRISON
 REGISTER OF DEEDS
 96 OCT -7 PM 3:24
 RECEIVED FOR RECORD
 344 844
 Register of Deeds Stamp & File Number

4. Lot No. _____, Recorded Plat _____
 5. Private Claims _____

I, William Lenca, in a field survey on Mar. 11, 19 96 do hereby state that under requirements of P.A. 74, Michigan P.A. of 1970, the corner points mentioned in lines 1 and 2 above were in conformance with regulations and rules therefore as required in the current manual of survey instructions of the United States Department of the Interior, Bureau of Land Management or by a decree of a Court of Law and /or that the corner points mentioned in lines 3, 4 and 5 above were in conformance with the rules of the Michigan Board of Land Surveyors or by a Decree of a Court of Law; established, re-established, monumented, recovered, found as expressed below:

NOTE: Not more than 2 corners, all in the same town and range, may be recorded on this certificate.

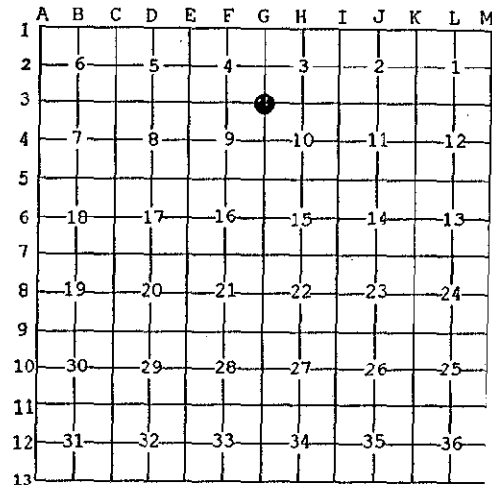


- A. Description of original monument and accessories and/or subsequent restoration:
- 1848: Original Survey by James H. Mullett - B.T.'s - Y. Pine, 13" - S37°E - 13 lks.; W. Pine, 16" - N37°W - 26 lks. Original corner evidence was destroyed by county road improvements.
 - 1977: L.C.R.C. No. 159 by George B. Wilson, RLS No. 17607, states: "Dug hole 12 feet square with county back hoe. Found old wood post partially decayed in subsoil, 4" square. Set concret monument 4" dia. x 36" long with 1/2" iron pin in center." NBT's: 6" Oak - N50°E - 50.00 feet; 5" Jack Pine - N30°E - 52.00 feet; 8" Triple Oak - N77°W - 107.70 feet.
 - 1978: CERTIFIED SURVEY NO. 59 by George B. Wilson, RLS No. 17607, describes this corner as a 4" round concrete mounument 36" long with 1/2" iron rod. No ties are given.

B. Description of corner evidence found and/or method applied in restoring or reestablishing corner:

We recovered a 4" diameter concrete monument with 1/2 inch diameter iron rod in location indicated by existing county road centerlines North and West. We also found the following B.T.'s described in L.C.R.C. No. 159: 6" Oak - N50°E - 50.00 feet; Stump of 8" Triple Oak - N77°W - 107.70 feet. George Wilson states in his corner record that he found an old wood post partially decayed, however, he does not state that it is an original post. We therefore accepted the existing concrete monument as the best available evidence of the position of the original corner.

C. Description of monument for corner and accessories established to perpetuate locating the position of the corner:
 Found 4" dia. concrete monument/1/2" iron pin in center/set 3-1/4" dia. Alum. cap stamped for corner location:

12" dia. White Pine	N82°E	119.10 feet	Scr. NBT
16" dia. White Pine	N68°W	141.92 feet	Scr. NBT
5" dia. Jack Pine	N19°E	79.04 feet	Scr. NBT
Nail in Power Pole	S54°W	35.36 feet	
Metal Survey Sign Post	East	36.7 feet	

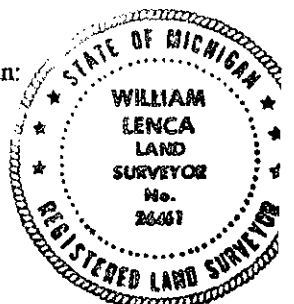

NOTE: All bearings are magnetic bearings. All distances are measured with EDM. Distances to trees are to nail in side of tree.

Signed by William Lenca
 Surveyor's Michigan License No. 26461

Date Mar. 26, 1996

344