

LAND CORNER RECORDATION CERTIFICATE  
 Filing Requirement of Act 74, Mich. P.A. 1970

For corners in

| <u>MENOMINEE</u><br>(County)          | Located In:                 | Corner Code # |
|---------------------------------------|-----------------------------|---------------|
| 1. Public Land Survey                 | T <u>34</u> N R <u>27</u> W | <u>G05</u>    |
|                                       | T ___ R ___                 | _____         |
|                                       | T ___ R ___                 | _____         |
|                                       | T ___ R ___                 | _____         |
| 2. Property Controlling<br>In Section | S ___ T ___ R ___           | _____         |
|                                       | S ___ T ___ R ___           | _____         |
| 3. Miscellaneous<br>Property in Sec.  | S ___ T ___ R ___           | _____         |
|                                       | S ___ T ___ R ___           | _____         |

RECEIVED FOR RECORD  
 96 OCT -7 PM 3:25  
 PAGE # 395 BK. 4  
 BARBARA MORRISON  
 REGISTER OF DEEDS  
 MENOMINEE, MI 49858

Register of Deeds Stamp & File Number

4. Lot No. \_\_\_\_\_, Recorded Plat \_\_\_\_\_  
 5. Private Claims \_\_\_\_\_

I, William Lenca, in a field survey on Mar. 11, 19 96 do hereby state that under requirements of P.A. 74, Michigan P.A. of 1970, the corner points mentioned in lines 1 and 2 above were in conformance with regulations and rules therefore as required in the current manual of survey instructions of the United States Department of the Interior, Bureau of Land Management or by a decree of a Court of Law and /or that the corner points mentioned in lines 3, 4 and 5 above were in conformance with the rules of the Michigan Board of Land Surveyors or by a Decree of a Court of Law; established, re-established, monumented, recovered, found as expressed below:

NOTE: Not more than 2 corners, all in the same town and range, may be recorded on this certificate.

| A  | B  | C | D  | E | F  | G | H  | I | J  | K | L  | M |
|----|----|---|----|---|----|---|----|---|----|---|----|---|
| 1  |    |   |    |   |    |   |    |   |    |   |    |   |
| 2  | 6  |   | 5  |   | 4  |   | 3  |   | 2  |   | 1  |   |
| 3  |    |   |    |   |    |   |    |   |    |   |    |   |
| 4  | 7  |   | 8  |   | 9  |   | 10 |   | 11 |   | 12 |   |
| 5  |    |   |    |   |    |   |    |   |    |   |    |   |
| 6  | 16 |   | 17 |   | 16 |   | 15 |   | 14 |   | 13 |   |
| 7  |    |   |    |   |    |   |    |   |    |   |    |   |
| 8  | 19 |   | 20 |   | 21 |   | 22 |   | 23 |   | 24 |   |
| 9  |    |   |    |   |    |   |    |   |    |   |    |   |
| 10 | 30 |   | 29 |   | 28 |   | 27 |   | 26 |   | 25 |   |
| 11 |    |   |    |   |    |   |    |   |    |   |    |   |
| 12 | 31 |   | 32 |   | 33 |   | 34 |   | 35 |   | 36 |   |
| 13 |    |   |    |   |    |   |    |   |    |   |    |   |


A. Description of original monument and accessories and/or subsequent restoration:

- 1848: Original Survey by James H. Mullett - B.T.'s - Y. Pine, 14" - N21°E - 14 lks.; Y. Pine, 14" - N22°W - 11 lks. All original evidence for this corner has been destroyed by county road improvements.
- 1901: Survey by Albert Haas, County Surveyor, states that a 4" Cedar Post was set from Gov. B.T. A distance of 40.02 chains (2641.3 feet) is shown from this corner North to the 1/4 Corner common to Sections 9 & 10, T34N-R27W.
- 1978: Certified Survey No. 56, by George B. Wilson, RLS No. 17607, shows this corner as "pin" in the intersection of county roads running East - West - South.

B. Description of corner evidence found and/or method applied in restoring or reestablishing corner:

We found a 1/2" diameter iron pin in the centerline of County Roads running East - West and South, and in line with an old fence line running North. The iron pin found was typical of corners set by George B. Wilson at other corners in Certified Survey No. 56. This corner has been used for at least 18 years by local surveyors, and is accepted as the best available evidence of the position of the original corner.

C. Description of monument for corner and accessories established to perpetuate locating the position of the corner:  
 Set 5/8" x 24" Iron Rod/3-1/4" dia. Alum. cap stamped for corner location in Monument Box:

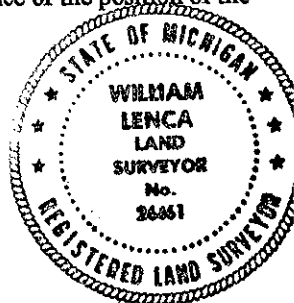

|   |       |            |                     |
|---|-------|------------|---------------------|
| 5/8" x 24" Iron Rod/2" dia. Alum. cap marked "WITNESS MARKER" | N62°E | 65.20 feet | 1' N. of Tel. Box   |
| 5/8" x 24" Iron Rod/2" dia. Alum. cap marked "WITNESS MARKER" | S38°W | 51.51 feet | 1' NW of Power Pole |
| 5/8" x 24" Iron Rod/2" dia. Alum. cap marked "WITNESS MARKER" | North | 32.25 feet |                     |
| 18" dia. White Pine   | S30°E | 84.65 feet | Scr. NBT            |
| Metal Survey Sign Post  | North | 32.75 feet |                     |

NOTE: All bearings are magnetic bearings. All distances are measured with steel tape. Distances to trees are to nail in side of tree.  
 Mar. 26, 1996

Signed by William Lenca  
 Surveyor's Michigan License No. 26461

Date \_\_\_\_\_