

APR 06 1999

P.A. Of 1990 On 10/29 1998
James S. Whinn P.S.
Chairman

SECTION

LAND CORNER RECORDATION CERTIFICATE
Filing Requirement of Act 74, Mich. P.A. 1970

For corners in

<u>MENOMINEE</u> (County)	Located In:	Corner Code #
1. Public Land Survey	T <u>34NR</u> <u>27W</u>	<u>H-01</u>
	T ___ R ___	___
	T ___ R ___	___
	T ___ R ___	___
2. Property Controlling in Section	S ___ T ___ R ___	___
	S ___ T ___ R ___	___
3. Miscellaneous Property in Sec.	S ___ T ___ R ___	___
	S ___ T ___ R ___	___

REGISTER OF DEEDS
MENOMINEE, MI 49880

PAGE # 671 BKS

98 DEC 14 PM 3:21

RECEIVED FOR RECORD

Register of Deeds Stamp & File Number

4. Lot No. _____, Recorded Plat _____
5. Private Claims _____
(SAME AS CORNER H-13, T35N - R27W)

I, William Lenca, in a field survey on Mar. 30, 1998 do hereby state that under requirements of P.A. 74, Michigan P.A. of 1970, the corner points mentioned in lines 1 and 2 above were in conformance with regulations and rules therefore as required in the current manual of survey instructions of the United States Department of the Interior, Bureau of Land Management or by a decree of a Court of Law and /or that the corner points mentioned in lines 3, 4 and 5 above were in conformance with the rules of the Michigan Board of Land Surveyors or by a Decree of a Court of Law, established, re-established, monumented, recovered, found as expressed below:

NOTE: Not more than 2 corners, all in the same town and range, may be recorded on this certificate.

A	B	C	D	E	F	G	H	I	J	K	L	M
1												
2	6		5		4		3		2		1	
3												
4	7		8		9		10		11		12	
5												
6	18		17		16		15		14		13	
7												
8	19		20		21		22		23		24	
9												
10	30		29		28		27		26		25	
11												
12	31		32		33		34		35		36	
13												

A. Description of original monument and accessories and/or subsequent restoration:

- 1847: Original Survey by H. Floyd - B.T.'s - Hemlock, 10" - S48°E - 16 lks.; Cedar, 8" - N80°W - 20 lks. All original evidence for this corner has been destroyed by logging activities, and river erosion. *Note: True Position falls in stream. Set corner 1.50 Chains south of line on bank of stream.
- 1901: Survey by Albert Hass shows he set a 4" Cedar Post equidistant and between Section corners. Nothing near for B.T.'s.
- 1983: L.C.R.C. Number 580 by George B. Wilson, RLS 17607, states, "Set HDR Berntsen Mon. at Corner. Set Deep 1 Magnet: 2 feet North; and 2 feet East." This corner was set by single proportion, and fits an old fence line.

B. Description of corner evidence found and/or method applied in restoring or reestablishing corner:


We found a Berntsen HDR Monument in a position matching a single proportional location as described in Land Corner Recordation Certificate Number 580. The corner falls North of the Little Cedar River, in line with an ancient fence line running North and with the centerline of a county road running South. This position has been accepted and used by local surveyors for at least 15 years, and is accepted as the best available evidence of the position of the original corner.

C. Description of monument for corner and accessories established to perpetuate locating the position of the corner:

Accepted Existing Berntsen HDR Monument and stamped it for corner location:

7" dia. Elm	N27°E	37.25 feet	Scr. NBT
9" dia. Elm	S46°E	22.02 feet	Scr. NBT
6" dia. Elm	S50°W	61.45 feet	Scr. NBT
12" dia. Elm	N75°W	28.29 feet	Scr. NBT
Metal Survey Sign Post	North	0.65 feet	
North Bank of Little Cedar River	South	89 feet	

NOTE: All bearings are magnetic bearings. All distances are measured with steel tape. Distances to trees are to nail in side of tree.

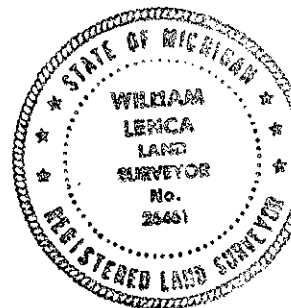

Signed by William Lenca
Surveyor's Michigan License No. 26461

Date Apr. 08, 1998