

LAND CORNER RECORDATION CERTIFICATE
 Filing Requirement of Act 74, Mich. P.A. 1970


For corners in
MENOMINEE
 (County)

| | | |
|------------------------------------|-------------|---------------|
| | Located in: | Corner Code # |
| 1. Public Land Survey | T34N R 27W | 104 |
| | T R | |
| | T R | |
| | T R | |
| 2. Property Controlling in Section | S T R | |
| | S T R | |
| 3. Miscellaneous Property in Sec. | S T R | |
| | S T R | |

4. Lot No. _____, Recorded Plat _____
 5. Private Claims _____

RECORDED IN RECORDS
 96 OCT -7 PM 3:25
 PAGE # 349 BK 4
 REGISTERED LAND SURVEYOR
 REGISTERED IN RECORDS

Register of Deeds Stamp & File Number

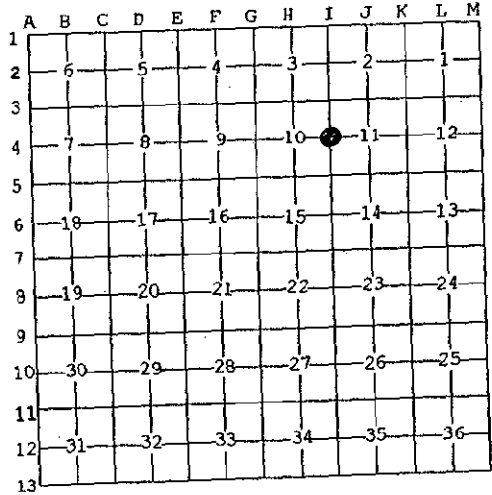

I, William Lenca, in a field survey on Mar. 14, 19 96 do hereby state that under requirements of P.A. 74, Michigan P.A. of 1970, the corner points mentioned in lines 1 and 2 above were in conformance with regulations and rules therefore as required in the current manual of survey instructions of the United States Department of the Interior, Bureau of Land Management or by a decree of a Court of Law and for that the corner points mentioned in lines 3, 4 and 5 above were in conformance with the rules of the Michigan Board of Land Surveyors or by a Decree of a Court of Law; established, re-established, monumented, recovered, found as expressed below:

NOTE: Not more than 2 corners, all in the same town and range, may be recorded on this certificate.


A. Description of original monument and accessories and/or subsequent restoration:
 1848: Original Survey by James H. Mullett - B.T.'s - Birch, 14" - S06°W - 11 lks.; Fir, 10" - S59°E - 04 lks. All original evidence for this corner has been destroyed by Highway construction.

B. Description of corner evidence found and/or method applied in restoring or reestablishing corner:
 This corner was re-established on a straight line and midway between the Northeast Corner (103) and the Southeast Corner (105) of Section 11, T34N-R27W. The corner thus established falls 37 feet West of the centerline of U.S Highway 41 and in the centerline of a county road running West. We accepted this location as a careful and faithful reestablishment of the position of the original corner.

C. Description of monument for corner and accessories established to perpetuate locating the position of the corner:
 Set 2" dia. Aluminum Pipe/3-1/4" dia. Alum cap stamped for corner location:

| | | | |
|--|-------|------------|----------|
| 5/8" x 24" Iron Rod/plastic Ident. cap marked MI 26461/WI 1569 | N22°W | 35.72 feet | |
| 8" dia. Black Ash | N20°W | 73.77 feet | SCR. NBT |
| 8" dia. White Ash | N76°W | 49.00 feet | SCR. NBT |
| 6" dia. White Pine | S35°W | 34.69 feet | SCR. NBT |
| Metal Survey Sign Post | N22°W | 36.2 feet | |

NOTE: All bearings are magnetic bearings. All distances are measured with EDM. Distances to trees are to nail in side of tree.

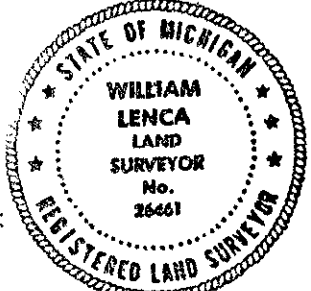

Signed by William Lenca
 Surveyor's Michigan License No. 26461

Date Mar. 26, 1996

349