

LAND CORNER RECORDATION CERTIFICATE  
Filing Requirement of Act 74, Mich. P.A. 1970

For corners in  
Menominee

(County)	Located In:	Corner Code ##
1. Public Land Survey	T _____ R _____	_____
	T _____ R _____	_____
	T _____ R _____	_____
	T _____ R _____	_____
2. Property Controlling in Section	S <u>11</u> T <u>35N</u> R <u>25W</u>	<u>3</u>
	S <u>11</u> T <u>35N</u> R <u>25W</u>	<u>4</u>
3. Miscellaneous Property in Sec.	S _____ T _____ R _____	_____
	S _____ T _____ R _____	_____

Register of Deeds Stamp & File Number

4. Lot No. \_\_\_\_\_, Recorded Plat \_\_\_\_\_  
5. Private Claims \_\_\_\_\_

I, Paul R. Bressette, in a field survey on February 28, 1996, 19\_\_\_\_\_, do hereby certify that under requirements of P.A. 74, Michigan P.A. of 1970, the corner points mentioned in lines 1 and 2 above were in conformance with regulations and rules therefore as required in the current manual of survey instructions of the United States Department of the Interior, Bureau of Land Management or by a decree of a Court of Law and/or that the corner points mentioned in lines 3, 4 and 5 above were in conformance with the rules of the Michigan Board of Land Surveyors or by a Decree of a Court of Law; established, re-established, monumented, re-monumented, recovered, found as expressed below:

NOTE: Not more than 4 corners, all in the same town and range, may be recorded on this certificate.

	A	B	C	D	E	F	G	H	I	J	K	L	M
2	6		5		4		3		2		1		
3													
4	7		8		9		10		11		12		
5													
6	18		17		16		15		14		13		
7													
8	19		20		21		22		23		24		
9													
10	30		29		28		27		26		25		
11													
12	31		32		33		34		35		36		
13													

A. Description of original monument and accessories and/or subsequent restoration:


- (3) North One-sixteenth corner common to Sections 10 and 11. Not set in original survey, no evidence of subsequent establishment.
- (4) Northwest One-sixteenth corner of Section 11. Not set in original survey, no evidence of subsequent establishment.

B. Description of corner evidence found and/or method applied in restoring or reestablishing corner:

- (3) Corner position established mid-point and on-line between the Northwest and West Quarter corners of Section 11.
- (4) Corner position established at the intersection of the North and West One-sixteenth lines of Section 11.

C. Description of monument for corner and accessories established to perpetuate locating the position of the corner:

- |  |  |
|--|--|
| (3) 1" pipe w/ 4" aluminum cap   | (4) 1" pipe w/ 4" aluminum cap   |
| 12" Sugar N73E 28.8'   | 5" Ash N01E 18.6'  |
| 5" Sugar S52E 39.45'   | 6" Ash N62E 8.9'   |
| 6" Sugar S15W 3.55'  | 10" Ash S12W 22.9'   |
| 8" Maple N04E 11.7'  | 4" Spruce S52W 42.3'   |
| All trees are blazed, scribed (1/16S, BT) and painted. Measurements are to notch in butt blaze. Bearings are magnetic. | All trees are blazed, scribed (1/16S, BT) and painted. Measurements are to notch in butt blaze. Bearings are magnetic. |

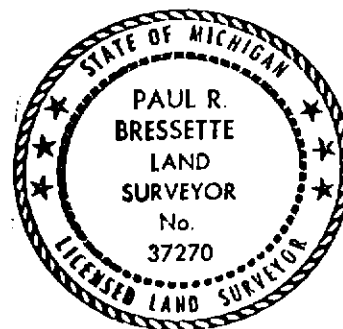

Signed by Paul R. Bressette Date 8-14-96  
Surveyor's Michigan License No. 37270