

LAND CORNER RECORDATION CERTIFICATE
Filing Requirement of Act 74, Mich. P.A. 1970

For corners in

Menominee

(County)

Located In:

Corner Code --//

- 1. Public Land Survey
2. Property Controlling in Section
3. Miscellaneous Property in Sec.

Register of Deeds Stamp & File Number

- 4. Lot No. , Recorded Plat
5. Private Claims

I, Paul R. Bressette, in a field survey on March 05, 1996, do hereby certify that under requirements of P.A. 74, Michigan P.A. of 1970, the corner points mentioned in lines 1 and 2 above were in conformance with regulations and rules therefore as required in the current manual of survey instructions of the United States Department of the Interior, Bureau of Land Management or by a decree of a Court of Law and/or that the corner points mentioned in lines 3, 4 and 5 above were in conformance with the rules of the Michigan Board of Land Surveyors or by a Decree of a Court of Law; established, re-established, monumented, re-monumented, recovered, found as expressed below:

NOTE: Not more than 4 corners, all in the same town and range, may be recorded on this certificate.

Grid table with columns A-M and rows 2-13. Contains numbers 1-36 and two dots in row 3, column L.

A. Description of original monument and accessories and/or subsequent restoration:


- (11) Southwest One-sixteenth corner of Section 1. Not set in original survey, no evidence of subsequent establishment.
(12) South One-sixteenth corner of Section 1. Not set in original survey, no evidence of subsequent establishment.

B. Description of corner evidence found and/or method applied in restoring or reestablishing corner:

- (11) Corner position established at the intersection of the south and west one-sixteenth lines of Section 1.
(12) Corner position established mid-point and on-line between the Center and South Quarter corners of Section 1.

C. Description of monument for corner and accessories established to perpetuate locating the position of the corner:

- (11) 1" pipe w/ 4" aluminum cap
8" Cedar N70E 29.0'
6" Cedar S17E 39.8'
8" Cedar S68W 21.9'
13" Cedar N13W 17.45'
All trees are blazed, scribed and painted. Measurements are to notch in butt blaze. Bearings are magnetic.
(12) 1" iron pipe w/ 4" aluminum cap
05" Cedar S88E 41.45'
12" Ash S24E 37.9'
05" Ash S58W 46.95'
08" Cedar N26W 53.2'
All trees are blazed, scribed (1/16S,8T) and painted. Measurements made to notch in butt blaze, bearings are magnetic.

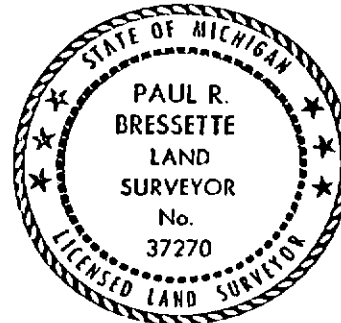

Signed by Paul R. Bressette Date 8-14-96
Surveyor's Michigan License No. 37270