

LAND CORNER RECORDATION CERTIFICATE
Filing Requirement of Act 74, Mich. P.A. 1970

For corners in
Menominee
(County)

Located In: Corner Code //

- 1 Public Land Survey
2 Property Controlling in Section
3 Miscellaneous Property in Sec.
S 1 T 35N R 25W REF 1/16 N OF 5

Register of Deeds Stamp & File Number

- 4 Lot No. , Recorded Plat
5 Private Claims

Grid table with columns A-M and rows 2-13. Cell (2,1) contains a small circle symbol.

I, Paul R. Bressette, in a field survey on March 05, 1996, do hereby certify that under requirements of P.A. 74, Michigan P.A. of 1970, the corner points mentioned in lines 1 and 2 above were in conformance with regulations and rules therefore as required in the current manual of survey instructions of the United States Department of the Interior, Bureau of Land Management or by a decree of a Court of Law and/or that the corner points mentioned in lines 3, 4 and 5 above were in conformance with the rules of the Michigan Board of Land Surveyors or by a Decree of a Court of Law; established, re-established, monumented, re-monumented, recovered, found as expressed below:

NOTE: Not more than 4 corners, all in the same town and range, may be recorded on this certificate.

A. Description of original monument and accessories and/or subsequent restoration:


- (5) North One-sixteenth corner of Section 1. Not set in original survey, no evidence of subsequent establishment.
(5-A) North North One-sixteenth corner of Section 1. Not set in original survey, no evidence of subsequent establishment. Section 1 is elongated, this corner is between the North Quarter corner and North One-sixteenth corner.

B. Description of corner evidence found and/or method applied in restoring or reestablishing corner.

- (5) Corner position established by single proportion between the North and Center Quarter corners of Section 1. Single proportion was used due to Section 1 being an elongated section. There is an additional one-sixteenth corner north of this corner.
(5-A) Corner position established by single proportion between the North and Center Quarter corners of Section 1.

C. Description of monument for corner and accessories established to perpetuate locating the position of the corner:

- (5) 1" iron pipe w/ 4" aluminum cap
08" Spruce N38E 12.35'
13" Cedar S54E 39.45'
08" W. Birch S68W 2.05'
08" W. Birch N40W 18.6'
All trees are blazed, scribed (1/16S,BT) and painted. Measurements are to notch in butt blaze, bearings are magnetic.
(5-A) 1" iron pipe w/ 4" aluminum cap
4" Ash N46E 27.4'
16" Cedar S53E 26.75'
16" Cedar S57W 50.0'
4" Ash N68W 7.75'
All trees are blazed, scribed (1/16S,BT) and painted. Measurements are to notch in butt blaze. Bearings are magnetic.

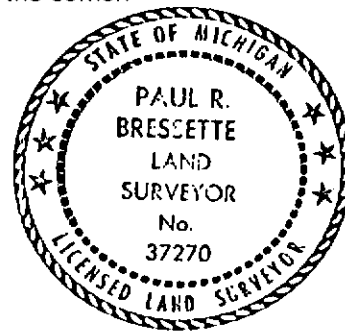

Signed by Paul R. Bressette Date 8-14-96
Surveyor's Michigan License No. 37270