

**SURVEY &
REMONUMENTATION**

JAN 09 2001

SECTION

LAND CORNER RECORDATION CERTIFICATE
Filing Requirement of Act 74, Mich. P.A. 1970

Approved by Menominee County
Land Survey Remonumentation
Peer Group Under Act 345 of
P.A. of 1990 On 7/13, 2000
W.L. Davis RLS
Chairman

For corners in
MENOMINEE
(County)

Located In: Corner Code #

1. Public Land Survey	T <u>35</u> N R <u>25</u> W	C-10
	T___ R___	_____
	T___ R___	_____
	T___ R___	_____
2. Property Controlling in Section	S___ T___ R___	_____
	S___ T___ R___	_____
3. Miscellaneous Property in Sec.	S___ T___ R___	_____
	S___ T___ R___	_____

Book 6 Page 184

RECEIVED FOR RECORD
13 DEC 2000 10:16:09 A
BARBARA MORRISON
REGISTER OF DEEDS
MENOMINEE, MI 49858

Register of Deeds Stamp & File Number

4. Lot No. _____, Recorded Plat _____
5. Private Claims _____

I, William Lenca, in a field survey on June 06, 1900 do hereby state that under requirements of P.A. 74, Michigan P.A. of 1970, the corner points mentioned in lines 1 and 2 above were in conformance with regulations and rules therefore as required in the current manual of survey instructions of the United States Department of the Interior, Bureau of Land Management or by a decree of a Court of Law and /or that the corner points mentioned in lines 3, 4 and 5 above were in conformance with the rules of the Michigan Board of Land Surveyors or by a Decree of a Court of Law, established, re-established, monumented, recovered, found as expressed below:

NOTE: Not more than 2 corners, all in the same town and range, may be recorded on this certificate.

A	B	C	D	E	F	G	H	I	J	K	L	M
1												
2	6		5		4		3		2		1	
3												
4	7		8		9		10		11		12	
5												
6	10		17		16		15		14		13	
7												
8	19		20		21		22		23		24	
9												
10	30		29		28		27		26		25	
11												
12	31		32		33		34		35		36	
13												

A. Description of original monument and accessories and/or subsequent restoration:

- 1848: Original Survey by James H. Mullett - B.T.'s - Tamarack, 6" - S40°E - 10 lks.; Cedar, 6" - N41°W - 21 lks. All original evidence for this corner has been destroyed by years of decay.
- 1970: L.C.R.C. No. 746, Volume 3, by Frank J. Bray, RLS, states that a 1" iron pipe with 4" alum. cap was placed midway between section corners to the north and south. B.T.'s: 7" S. Maple - N79°W - 31.4'; 9" B. Ash - S38°E - 24.3'.


B. Description of corner evidence found and/or method applied in restoring or reestablishing corner:

We recovered a 1 inch diameter iron pipe with a 4 inch diameter aluminum cap along with 2 B.T.'s as described in L.C.R.C. No. 746 (see part A). The corner fits well with a single proportional location, and is accepted as a careful and faithful reestablishment of the position of the original corner.

C. Description of monument for corner and accessories established to perpetuate locating the position of the corner:

Accepted Existing 1-1/2" dia. Iron Pipe/4" Alum. Cap stamped for corner location.

9" dia. Maple	N79°W	31.70 feet	Scr. NBT
12" dia. Black Ash	S38°E	24.58 feet	Scr. NBT
6" dia. Maple	N20°W	34.29 feet	Scr. NBT
9" dia. Black Ash	N45°E	48.98 feet	Scr. NBT
Metal Survey Sign Post	N33°E	40.0 feet	

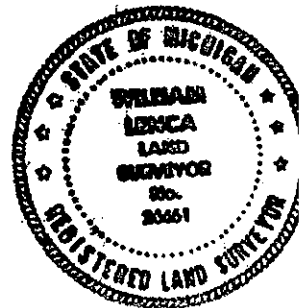

NOTE: All bearings are magnetic bearings. All distances are measured with steel tape. Distances to trees are to nail in side of tree.

Signed by William Lenca
Surveyor's Michigan License No. 26461

Date June 30, 2000

180