

SURVEY & REMONUMENTATION

JAN 09 2001

SECTION

LAND CORNER RECORDATION CERTIFICATE
Filing Requirement of Act 74, Mich. P.A. 1970

Approved by Menominee County
Land Survey Remonumentation
Peer Group Under Act 345 of
P.A. 01 1990 On 7/13, 2000
WILL DAVIS RLS
Chairman

For corners in
MENOMINEE
(County)

Located In: Corner Code #

1. Public Land Survey	T <u>35N</u> R <u>25W</u>	D-09
	T _____ R _____	_____
	T _____ R _____	_____
	T _____ R _____	_____
2. Property Controlling in Section	S _____ T _____ R _____	_____
	S _____ T _____ R _____	_____
3. Miscellaneous Property in Sec.	S _____ T _____ R _____	_____
	S _____ T _____ R _____	_____

Book 6 Page 185

RECEIVED FOR RECORD
13 DEC 2000 10:16:09 A
BARBARA MORRISON
REGISTER OF DEEDS
MENOMINEE, MI 49858

Register of Deeds Stamp & File Number

4. Lot No. _____, Recorded Plat _____
5. Private Claims _____

I, William Lenca, in a field survey on May 30, 1900 do hereby state that under requirements of P.A. 74, Michigan P.A. of 1970, the corner points mentioned in lines 1 and 2 above were in conformance with regulations and rules therefore as required in the current manual of survey instructions of the United States Department of the Interior, Bureau of Land Management or by a decree of a Court of Law and /or that the corner points mentioned in lines 3, 4 and 5 above were in conformance with the rules of the Michigan Board of Land Surveyors or by a Decree of a Court of Law, established, re-established, monumented, recovered, found as expressed below:

NOTE: Not more than 2 corners, all in the same town and range, may be recorded on this certificate.

A	B	C	D	E	F	G	H	I	J	K	L	M
1												
2	6		5		4		3		2		1	
3												
4	7		8		9		10		11		12	
5												
6	18		17		16		15		14		13	
7												
8	19		20		21		22		23		24	
9												
10	30		29		28		27		26		25	
11												
12	31		32		33		34		35		36	
13												

A. Description of original monument and accessories and/or subsequent restoration:

- 1848: Original Survey by James H. Mullett - B.T.'s - Tamarack, 16" - N81°E - 24 lks.; Birch, 10" - N10°W - 10 lks. All original evidence for this corner has been destroyed by county road improvements.
- 1970: L.C.R.C. No. 763, Volume 3, by Frank J. Bray, RLS, states that a 1/2" x 12" re-rod was driven in blacktop road, replaced from measurements to fence corner and power pole as recorded by the Menominee County Road Commission in 1949. Corner lies in line with approx. c/l of gravel road to the north.


B. Description of corner evidence found and/or method applied in restoring or reestablishing corner:

We recovered a 1/2 inch x 12 inch re-rod in the centerline of County Roads East - West and North, and in line with an old fence line running South. This corner matches existing lines of occupation and fits well with measurements to corners 1/2 mile East and West, and is accepted as the best available evidence of the position of the original corner.

C. Description of monument for corner and accessories established to perpetuate locating the position of the corner:

Set 5/8" x 24" Iron Rod/3-1/4" dia. Alum. cap stamped for corner location in Monument Box:

5/8" x 24" Iron Rod/ID cap	N33°E	39.68 feet	
Twin 5" dia. White Ash	S60°E	58.33 feet	Scr. NBT
12" dia. White Ash	S06°E	29.72 feet	Scr. NBT
12" dia. White Ash	S60°W	64.88 feet	Scr. NBT
Metal Survey Sign Post	N33°E	40.0 feet	

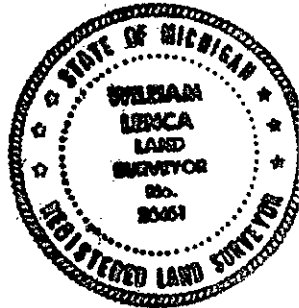

NOTE: All bearings are magnetic bearings. All distances are measured with steel tape. Distances to trees are to nail in side of tree.

Signed by William Lenca
Surveyor's Michigan License No. 26461

Date June 3, 2000

185