

**SURVEY & REMONUMENTATION**

**JAN 09 2001**

**SECTION**

Approved by Menominee County  
Land Survey Remonumentation  
Peer Group Under Act 345 of  
P.A. Of 1990 On 7/13, 2000  
McDermott RLS  
Chairman

**LAND CORNER RECORDATION CERTIFICATE**  
Filing Requirement of Act 74, Mich. P.A. 1970

For corners in <u>MENOMINEE</u> (County)	Located in:	Corner Code #
1. Public Land Survey	T <u>35N</u> R <u>25W</u>	<u>F-09</u>
	T ___ R ___	_____
	T ___ R ___	_____
	T ___ R ___	_____
2. Property Controlling in Section	S ___ T ___ R ___	_____
	S ___ T ___ R ___	_____
3. Miscellaneous Property in Sec.	S ___ T ___ R ___	_____
	S ___ T ___ R ___	_____


*Book 6 Page 190*

RECEIVED FOR RECORD  
13 DEC 2000 10:16:09 A  
BARBARA MORRISON  
REGISTER OF DEEDS  
MENOMINEE, MI 49858

Register of Deeds Stamp & File Number

4. Lot No. \_\_\_\_\_, Recorded Plat \_\_\_\_\_  
5. Private Claims \_\_\_\_\_

I, William Lenca, in a field survey on June 26, 1900 do hereby state that under requirements of P.A. 74, Michigan P.A. of 1970, the corner points mentioned in lines 1 and 2 above were in conformance with regulations and rules therefore as required in the current manual of survey instructions of the United States Department of the Interior, Bureau of Land Management or by a decree of a Court of Law and/or that the corner points mentioned in lines 3, 4 and 5 above were in conformance with the rules of the Michigan Board of Land Surveyors or by a Decree of a Court of Law; established, re-established, monumented, recovered, found as expressed below:

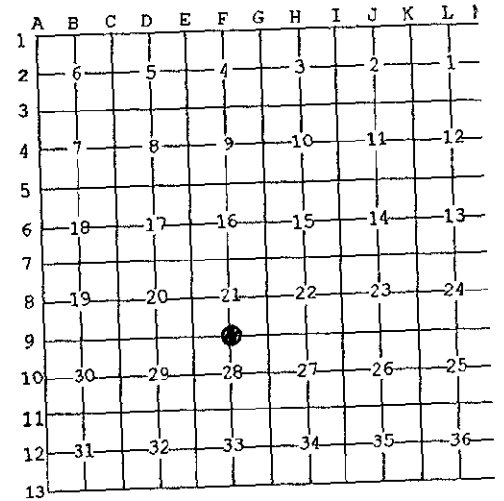

NOTE: Not more than 2 corners, all in the same town and range, may be recorded on this certificate.

**A. Description of original monument and accessories and/or subsequent restoration:**

- 1848: Original Survey by James H. Mullett - B.T.'s - Hemlock, 12" - S19°W - 11 lks.; Beech, 4" - S35°E - 21 lks. All original evidence for this corner has been destroyed by county road improvements.
- 1994: Private records of William Lenca, RLS No. 26461, indicate that a railroad spike was set in the centerline of an East - West County Road and in line with an ancient fence line running North.

**B. Description of corner evidence found and/or method applied in restoring or reestablishing corner:**

We recovered a Railroad Spike in the centerline of an East - West County road and in line with an old fence line running North. This position fits well with measurements to other corners and occupation lines in the area, and is accepted as the best available evidence of the position of the original corner.



**C. Description of monument for corner and accessories established to perpetuate locating the position of the corner:**

Set 5/8" x 24" Iron Rod/3-1/4" dia. Alum. cap stamped for corner location in Monument Box:

5/8" x 24" Iron Rod/2" dia. Alum. cap marked "WITNESS MARKER"	South	36.65 feet	0.6' N. of IP
5/8" x 24" Iron Rod/2" dia. Alum. cap marked "WITNESS MARKER"	North	33.30 feet	
Twin 6" dia. Maples	N43°E	76.03 feet	Scr. NBT
8" dia. Maple	S67°W	77.95 feet	Scr. NBT
Metal Survey Sign Post	North	33.75 feet	

NOTE: All bearings are magnetic bearings. All distances are measured with steel tape. Distances to trees are to nail in side of tree.

Signed by William Lenca  
Surveyor's Michigan License No. 26461

Date June 30, 2000