

**SURVEY & REMONUMENTATION**

**JAN 09 2001**

**SECTION**

**LAND CORNER RECORDATION CERTIFICATE**  
Filing Requirement of Act 74, Mich. P.A. 1970


Approved by Menominee County  
Land Survey Remonumentation  
Peer Group Under Act 345 of  
P.A. Of 1990 On 7/13 2000  
W. M. RLS  
Chairman

*Book 6 Page 194*

For corners in  
MENOMINEE  
(County)

Located In:	Corner Code #
T <u>35</u> N R <u>25</u> W	I-03
T___ R___	_____
T___ R___	_____
T___ R___	_____
S___ T___ R___	_____
S___ T___ R___	_____
S___ T___ R___	_____
S___ T___ R___	_____

- 1. Public Land Survey
- 2. Property Controlling in Section
- 3. Miscellaneous Property in Sec.

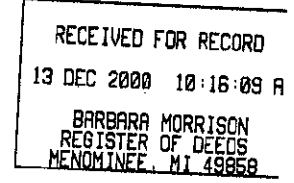

Register of Deeds Stamp & File Number

4. Lot No. \_\_\_\_\_, Recorded Plat \_\_\_\_\_  
5. Private Claims \_\_\_\_\_

	A	B	C	D	E	F	G	H	I	J	K	L	M
1													
2	6			5			4		3		2		1
3													
4	7			8			9		10		11		12
5													
6	18			17			16		15		14		13
7													
8	19			20			21		22		23		24
9													
10	30			29			28		27		26		25
11													
12	31			32			33		34		35		36
13													

I, William Lenca, in a field survey on June 28, 1900 do hereby state that under requirements of P.A. 74, Michigan P.A. of 1970, the corner points mentioned in lines 1 and 2 above were in conformance with regulations and rules therefore as required in the current manual of survey instructions of the United States Department of the Interior, Bureau of Land Management or by a decree of a Court of Law and /or that the corner points mentioned in lines 3, 4 and 5 above were in conformance with the rules of the Michigan Board of Land Surveyors or by a Decree of a Court of Law; established, re-established, monumented, recovered, found as expressed below:


NOTE: Not more than 2 corners, all in the same town and range, may be recorded on this certificate.

A. Description of original monument and accessories and/or subsequent restoration:

- 1848: Original Survey by James H. Mullett - B.T.'s - Birch, 12" - S49°E - 19 lks.; Cedar, 10" - N53°W - 37 lks. All original evidence for this corner has been destroyed by county road improvements.
- 1956: L.C.R.C. No. 19, Volume 2, by Billy D. Buckler, RLS, states that a 1/2" x 3' steel bar was placed in East shoulder of present road 8" below surface. Established section corner by proportionate measure North & South and in old road location according to Gov't notes. B.T.'s: 7" H. Maple - S86°E - 45 lks; 9" W. Ash - S26°E - 41 lks.
- 1983: Private records of William Lenca, RLS No. 26461, indicate the corner described in LCRC was replaced with an aluminum W-1-B Berntsen Monument with magnet in cover.

B. Description of corner evidence found and/or method applied in restoring or reestablishing corner:

We found an aluminum W-1-B Berntsen Monument 30 inches long with a 4 inch diameter aluminum cap on the East shoulder of County Road No. 551, along with the 2 B.T.'s described in LCRC No. 19, Volume 2 (see part A). This corner has been accepted and used by local surveyors for at least 44 years, and is accepted as the best available evidence of the position of the original corner.

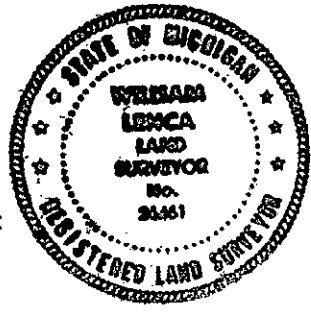

C. Description of monument for corner and accessories established to perpetuate locating the position of the corner:

Accepted existing W-1-B Berntsen Monument 30" long with 4" dia. Alum. cap stamped for corner location:

11" dia. Hard Maple (Ex. B.T.)	S86°E	29.45 feet	Scr. NBT
11" dia. Yellow Birch	S02°W	58.75 feet	Scr. NBT
5/8" x 24" Iron Rod/2" dia. Alum. cap marked "WITNESS MARKER"	N62°W	38.77 feet	
3/4" dia. Iron Pipe/Ident. cap	North	72.36 feet	
Metal Survey Sign Post	N62°W	39.6 feet	

NOTE: All bearings are magnetic bearings. All distances are measured with steel tape. Distances to trees are to nail in side of tree.

Signed by William Lenca  
Surveyor's Michigan License No. 26461

Date June 30, 2000