


**LAND CORNER RECORDATION CERTIFICATE**  
 Filing Requirement of Act 74, Mich. P.A. 1970

For corners in  
 Menominee  
 (County)

Located In:

Corner Code #

- |                                       |   |            |   |            |                            |
|---------------------------------------|---|------------|---|------------|----------------------------|
| 1. Public Land Survey                 | T | <u>36N</u> | R | <u>25W</u> | <u>J13 (J1 T35N, R25W)</u> |
|                                       | T | <u>36N</u> | R | <u>25W</u> | <u>K13 (K1 T35N, R25W)</u> |
|                                       | T |            | R |            |                            |
|                                       | T |            | R |            |                            |
| 2. Property Controlling<br>In Section | S |            | T |            | R                          |
|                                       | S |            | T |            | R                          |
| 3. Miscellaneous<br>Property in Sec.  | S |            | T |            | R                          |
|                                       | S |            | T |            | R                          |

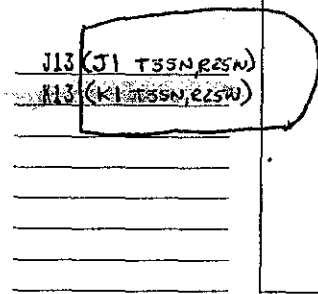

RECORDED FOR RECORD  
 96 JAN -3 AM 10:53  
 PAGE# 381 BK 4  
 BARBARA JOHNSON  
 REGISTER OF DEEDS  
 MENOMINEE COUNTY

Register of Deeds Stamp & File Number

4. Lot No. \_\_\_\_\_, Recorded Plat \_\_\_\_\_  
 5. Private Claims \_\_\_\_\_

A	B	C	D	E	F	G	H	I	J	K
2	6	5	4	3	2					
3										
4	7	8	9	10	11					
5										
6	18	17	16	15	14					
7										
8	19	20	21	22	23					
9										
10	30	29	28	27	26					
11										
12	31	32	33	34	35					
13										

I, Paul R. Brette, in a field survey on K13 May 08, 1995, 1995, do hereby certify that under requirements of P.A. 74, Michigan P.A. of 1970, the corner points mentioned in lines 1 and 2 above were in conformance with regulations and rules therefore as required in the current manual of survey instructions of the United States Department of the Interior, Bureau of Land Management or by a decree of a Court of Law and/or that the corner points mentioned in lines 3, 4 and 5 above were in conformance with the rules of the Michigan Board of Land Surveyors or by a Decree of a Court of Law; established, re-established, monumented, re-monumented, recovered, found as expressed below:

**NOTE: Not more than 4 corners, all in the same town and range, may be recorded on this certificate.**

A. Description of original monument and accessories and/or subsequent restoration:

(J13) Quarter corner common to Sections 35 and 2. 1848: James H. Mullett, DS. Set wood post witnessed by: Birch 14 N73E 16 lk Cedar 14 N17W 30 lks. 1955: Billy Buckler, RLS. Set 1" iron pipe with 4" brass cap from original Y. Birch BT and cedar stump in position for second original BT witnessed by: 14" Y. Birch N15E 48 lks.; 9" Cedar S57W 32 lks. Corner recorded in Volume 55 of Menominee County Records.  
 (K13) Section corner common to Sections 35, 36, 1 and 2. 1848: James H. Mullett, DS. Set wood post witnessed by: Cedar 6 N38W lks.; Spruce 10 N52E 14 lks. 1848: James H. Mullett, DS. Closed on corner during subdivision of T35N, R25W. Marked two addi witnesses: Spruce 12 S38W 11 lks.; Spruce 12 S26E 17 lks.

B. Description of corner evidence found and/or method applied in restoring or reestablishing corner:

(J13) Found Buckler's monument and witnesses as described. Y. Birch NBT is alive and standing N19E 31.9' from monument with bot faces completely closed. Cedar NBT is alive and standing with faces open and scribing plain. Monument was rewitnessed as found accepted as a careful and faithful PERPETUATION of the position of the original corner. A new witness was marked to replace the Birch due to the faces being closed and the advanced age of the tree.  
 (K13) No evidence of original survey or restoration found. Corner position re-established mid-point and on-line between the Soul Quarter corner of Section 35 and the South Quarter corner of Section 36, and is accepted as a careful and faithful REESTABLISHMENT of the position of the original corner.

C. Description of monument for corner and accessories established to perpetuate locating the position of the corner:

(J13) 1" iron pipe w/ 4" brass cap  
 8" Hemlock N07E 21.75' (1/4S, NBT)  
 9" R. Maple S21E 7.65' (1/4S, NBT)  
 11" Cedar S61W 21.3' old NBT  
 10" Ash N35W 28.8' (1/4S, NBT)  
 All NBT's are blazed, scribed, painted and tagged. A metal post with sign was placed next to monument. Distances are measured to notch in butt blaze, bearings are magnetic.

(K13) 1" iron pipe w/ 4" aluminum cap  
 8" Cedar N31E 12.3' (S36, NBT)  
 8" Cedar S54E 34.25' (S1, NBT)  
 6" Cedar S05W 20.7' (S2, NBT)  
 8" Cedar N82W 25.15' (S35, NBT)  
 All NBT's are blazed, scribed, painted and tagged. A metal post with sign was placed next to monument. Distances are measured to notch in butt blaze, bearings are magnetic.



Signed by Paul R. Brette

Date 1-3-96

Surveyor's Michigan License No. 37270