SURVEY & REMONUMENTATION

MAR 29 2000

SECTION

Approved by Menominee County Land Survey Remonumentation Peer Group Under Act 345 Of P.A. Of 1990 On 12/28 1999
Mel Davis RLS
Chairman

LAND CORNER RECORDATION CERTIFICATE
Filing Requirement of Act 74, Mich. P.A. 1970

Bk. 6 Pg. 88

RECEIVED FOR RECORD
28 DEC 1999 3:56:09 PM
BARBARA MORRISON
REGISTER OF DEEDS
MENOMINEE, MI 49858

Register of Deeds Stamp & File Number

For corners in

MENOMINEE (County) Located In: Corner Code #

1. Public Land Survey T 35N R 27W M-6
T___ R___
T___ R___
T___ R___
2. Property Controlling in Section S___ T___ R___
S___ T___ R___
3. Miscellaneous Property in Sec. S___ T___ R___
S___ T___ R___

4. Lot No. _____, Recorded Plat _____
5. Private Claims _____

SAME AS CORNER A-6, T35N-R26W

I, William Lenca, in a field survey on Nov., 19 99 do hereby state that under requirements of P.A. 74, Michigan P.A. of 1970, the corner points mentioned in lines 1 and 2 above were in conformance with regulations and rules therefore as required in the current manual of survey instructions of the United States Department of the Interior, Bureau of Land Management or by a decree of a Court of Law and /or that the corner points mentioned in lines 3, 4 and 5 above were in conformance with the rules of the Michigan Board of Land Surveyors or by a Decree of a Court of Law; established, re-established, monumented, recovered, found as expressed below:

NOTE: Not more than 2 corners, all in the same town and range, may be recorded on this certificate.

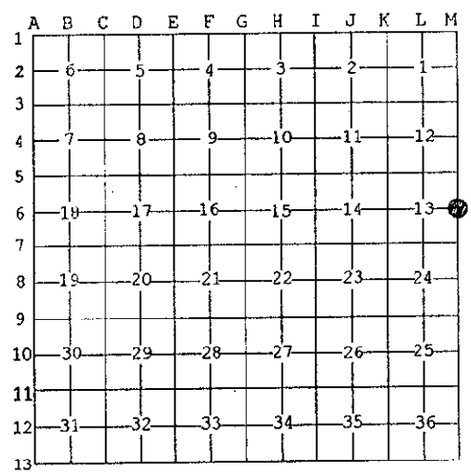

A. Description of original monument and accessories and/or subsequent restoration:

1847: Twp. Boundary by H. Floyd - B.T.'s - Hemlock, 9" - S57°W - 12 lks; Cedar, 12" - N43°W - 34 lks. All original evidence for this corner has been destroyed by county road improvements.

B. Description of corner evidence found and/or method applied in restoring or reestablishing corner:

Finding no evidence of the original corner accessories, or evidence of subsequent restoration, we accepted a corner position falling in line with the centerline of County Roads running East - West and South and in line with the extension South of an ancient fence running North. This position fits reasonably well with measurements to corners 1/2 mile North (2663.25 feet) and 1/2 mile South (2685.59 feet), fits well with existing lines of occupation, and is accepted as the best available evidence of the position of the original corner.

C. Description of monument for corner and accessories established to perpetuate locating the position of the corner:

STATE OF MICHIGAN WILLIAM LENCA LAND SURVEYOR No. 26461 REGISTERED LAND SURVEYOR

Set 5/8" x 24" Iron Rod/3-1/4" dia. Alum. cap stamped for corner location in Monument Box:

9" dia. White Ash	N 11° E	85.96 feet	Scr. NBT
6" dia. Cedar	S 25° E	44.02 feet	Scr. NBT
8" dia. White Ash	S 75° W	131.98 feet	Scr. NBT
Nothing else nearby			
Metal Survey Sign Post	South	33.50 feet	

NOTE: All bearings are magnetic bearings. All distances are measured with steel tape. Distances to trees are to nail in side of tree.

Signed by William Lenca Date Nov. 23, 1999

Surveyor's Michigan License No. 26461

FORM APPROVED BY MICHIGAN STATE BOARD OF PROFESSIONAL SURVEYORS, JAN. 28, 1971
REVISED MAY 14, 1975
REVISED JAN., 1983
REVISED OCT., 1995