

LAND CORNER RECORDATION CERTIFICATE
 Filing Requirement of Act 74, Mich. P.A. 1970

For corners in
MENOMINEE
 (County)


1. Public Land Survey	Located in:	Corner Code #
	T35N R. 26W	C-07
	T ___ R ___	_____
	T ___ R ___	_____
	T ___ R ___	_____
2. Property Controlling in Section	S ___ T ___ R ___	_____
	S ___ T ___ R ___	_____
3. Miscellaneous Property in Sec.	S ___ T ___ R ___	_____
	S ___ T ___ R ___	_____

RECORDED FOR RECORD
 97 JUL 23 PM 3:34
 PAGE # 490 BK 5
 BARBARA KORNENSON
 REGISTER OF DEEDS
 MENOMINEE MI 49833
 Register of Deeds Stamp & File Number

4. Lot No. _____, Recorded Plat _____
 5. Private Claims _____

I, William Lenca, in a field survey on May 20, 19 97 do hereby state that under requirements of P.A. 74, Michigan P.A. of 1970, the corner points mentioned in lines 1 and 2 above were in conformance with regulations and rules therefore as required in the current manual of survey instructions of the United States Department of the Interior, Bureau of Land Management or by a decree of a Court of Law and /or that the corner points mentioned in lines 3, 4 and 5 above were in conformance with the rules of the Michigan Board of Land Surveyors or by a Decree of a Court of Law; established, re-established, monumented, recovered, found as expressed below:

NOTE: Not more than 2 corners, all in the same town and range, may be recorded on this certificate.

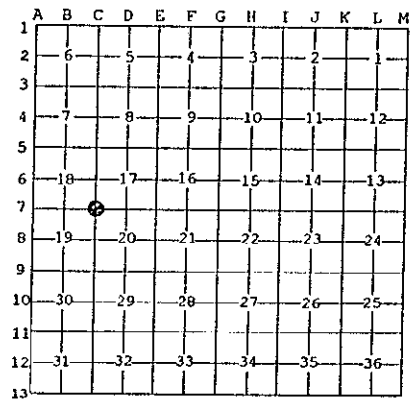

A. Description of original monument and accessories and/or subsequent restoration:

1848: Original Survey by James H. Mullett - B.T.'s - Hemlock, 14" - S56°W - 38 lks.; Hemlock, 16" - N72°W - 44 lks. All original evidence for this corner has been destroyed by County Road improvements.

B. Description of corner evidence found and/or method applied in restoring or reestablishing corner:

We found a 5/8 inch x 24 inch iron rod in the centerline of county roads North - South and East and in a position that fits very closely with a single proportional position between the N1/4 Corner (B-7) of Section 19 and the N1/4 Corner (D-7) of Section 20, T35N-R26W. This location was accepted as the best available evidence of the position of the original corner.



C. Description of monument for corner and accessories established to perpetuate locating the position of the corner:
 Set 2" dia. Aluminum Pipe 30" long/3-1/4" dia. Alum cap stamped for corner location:

6" dia. Cedar	N19°E	70.87 feet	Scr. NBT
10" dia. Cedar	N66°E	80.16 feet	Scr. NBT
5/8" x 24" Iron Rod/2" dia. Alum. cap marked "WITNESS MARKER"	S63°E	28.56 feet	0.9' S. of Stop Sign
5/8" x 24" Iron Rod/2" dia. Alum. cap marked "WITNESS MARKER"	West	33.00 feet	
Metal Survey Sign Post	West	33.5 feet	

NOTE: All bearings are magnetic bearings. All distances are measured with steel tape. Distances to trees are to nail in side of tree.

Signed by William Lenca
 Surveyor's Michigan License No. 26461

Date June 06, 1997

REMONUMENTATION

DEC 22 1997
 COMMISSION

490