SURVEY
RECEIVED
APR 06 1999
SECTION

Approved by Menominee County
Land Survey Remonumentation
Peer Group Under Act 345 Of
P.A. Of 1990 On 12/14, 1998
Mel Davis PLS
Chairman

LAND CORNER RECORDATION CERTIFICATE
Filing Requirement of Act 74, Mich. P.A. 1970

RECEIVED FOR RECORD
99 JAN 27 PM 1:32
PAGE # 746 BKS
BARBARA MORRISON
REGISTER OF DEEDS
MENOMINEE, MI 49858

For corners in

MENOMINEE
(County)

Located In: Corner Code #

1. Public Land Survey		T35N	R 26W	C-11
		T___	R___	
		T___	R___	
		T___	R___	
2. Property Controlling in Section	S___	T___	R___	
	S___	T___	R___	
3. Miscellaneous Property in Sec.	S___	T___	R___	
	S___	T___	R___	

Register of Deeds Stamp & File Number

4. Lot No. _____ , Recorded Plat _____
5. Private Claims _____

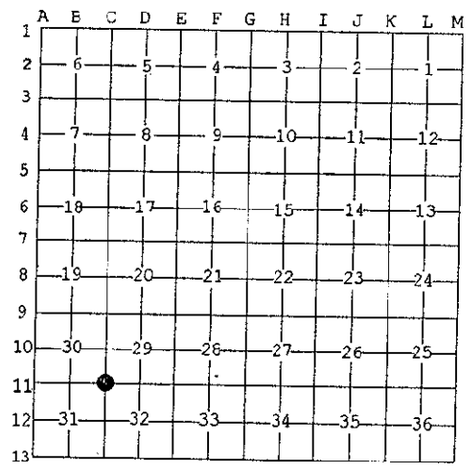

I, William Lenca, in a field survey on June 18, 19 98 do hereby state that under requirements of P.A. 74, Michigan P.A. of 1970, the corner points mentioned in lines 1 and 2 above were in conformance with regulations and rules therefore as required in the current manual of survey instructions of the United States Department of the Interior, Bureau of Land Management or by a decree of a Court of Law and /or that the corner points mentioned in lines 3, 4 and 5 above were in conformance with the rules of the Michigan Board of Land Surveyors or by a Decree of a Court of Law; established, re-established, monumented, recovered, found as expressed below:

NOTE: Not more than 2 corners, all in the same town and range, may be recorded on this certificate.

A. Description of original monument and accessories and/or subsequent restoration:

1848: Original Survey by James H. Mullett - B.T.'s - Hemlock, 10" - S41°E - 12 lks.; Beech, 8" - N37°E - 15 lks. All original evidence for this corner has been destroyed by county road improvements.

B. Description of corner evidence found and/or method applied in restoring or reestablishing corner:

We found a 1/2 inch iron in the centerline of county roads North and West. This position has been used for many years and is accepted as the best available evidence of the position of the original corner.

STATE OF MICHIGAN
WILLIAM LENCA
LAND SURVEYOR
No. 26461
REGISTERED LAND SURVEYOR

C. Description of monument for corner and accessories established to perpetuate locating the position of the corner:

Set 2" dia. Aluminum Pipe 30" long/3-1/4" dia. Alum cap stamped for corner location:

5/8" x 24" Iron Rod/2" dia. Alum. cap marked "WITNESS MARKER"	N48°E	28.78 feet	1' W. of P.P.
12" dia. Elm	S75°W	38.43 feet	Scr. NBT
5/8" x 24" Iron Rod/2" dia. Alum. cap marked "WITNESS MARKER"	N41°W	93.60 feet	1.5' S.E. of 12" Maple
Metal Survey Sign Post	East	1.4 feet	

NOTE: All bearings are magnetic bearings. All distances are measured with steel tape. Distances to trees are to nail in side of tree.

Signed by William Lenca Date Aug. 24, 1998
Surveyor's Michigan License No. 26461

FORM APPROVED BY MICHIGAN STATE BOARD OF PROFESSIONAL SURVEYORS, JAN. 28, 1971
REVISED MAY 14,1975
REVISED JAN., 1983
REVISED OCT., 1995

746