

SURVEY & REMONUMENTATION

JAN 09 2001

SECTION

LAND CORNER RECORDATION CERTIFICATE Filing Requirement of Act 74, Mich. P.A. 1970

Approved by Menominee County
Land Survey Remonumentation
Peer Group Under Act 345 of
P.A. Of 1990 On 7/13, 2000
Mc Davis RLS
Chairman

For corners in
MENOMINEE

(County)

Located In: Corner Code #

1. Public Land Survey	T <u>35N</u> R <u>26W</u>	E-2
	T ___ R ___	___
	T ___ R ___	___
	T ___ R ___	___
2. Property Controlling in Section	S ___ T ___ R ___	___
	S ___ T ___ R ___	___
3. Miscellaneous Property in Sec.	S ___ T ___ R ___	___
	S ___ T ___ R ___	___

Book 6 Page 148

RECEIVED FOR RECORD
13 DEC 2000 10:16:09 A
BARBARA MORRISON
REGISTER OF DEEDS
MENOMINEE, MI 49858

Register of Deeds Stamp & File Number

4. Lot No. _____, Recorded Plat _____
5. Private Claims _____

I, William Lenca, in a field survey on Oct., 1900 do hereby state that under requirements of P.A. 74, Michigan P.A. of 1970, the corner points mentioned in lines 1 and 2 above were in conformance with regulations and rules therefore as required in the current manual of survey instructions of the United States Department of the Interior, Bureau of Land Management or by a decree of a Court of Law and /or that the corner points mentioned in lines 3, 4 and 5 above were in conformance with the rules of the Michigan Board of Land Surveyors or by a Decree of a Court of Law; established, re-established, monumented, recovered, found as expressed below:

NOTE: Not more than 2 corners, all in the same town and range, may be recorded on this certificate.


1	A	B	C	D	E	F	G	H	I	J	K	L	N
2		6		5	●	4		3		2		1	
3													
4		7		8		9		10		11		12	
5													
6		18		17		16		15		14		13	
7													
8		19		20		21		22		23		24	
9													
10		30		29		28		27		26		25	
11													
12		31		32		33		34		35		36	
13													

A. Description of original monument and accessories and/or subsequent restoration:

- 1848: Original Survey by James H. Mullett - B.T.'s - Birch, 15" - S73°W - 32 lks.; Sugar, 12" - S15°E - 30 lks.; All original evidence for this corner has been destroyed by farming activities.
- 1901: Minutes of Survey in Section 4 by Albert Hass, Co. Surveyor, states "Set 4" Hemlock post from Gov. B.T. - destroyed by farming activities.
- 1987: L.C.R.C. No. 769, Book 3, by William Lenca, RLS No. 26461 states "Set 1/2" x 24" Iron Rod/Ident. cap in line with c/l of lane E-W and in line with fences N- S. This position was used by other surveyors. TIES: Nail in 5" Cherry, Scr. B.T., South, 80.00'; Nail in 4" Cedar, Scr. B.T., S67°W, 40.05'; Nail in 7" Cherry, Scr. B.T., N39°W, 32.70'.

B. Description of corner evidence found and/or method applied in restoring or reestablishing corner:

We found a 5/8 inch diameter iron rod in the centerline of an old lane East - West and in line with old fence lines running North and South. There is no evidence of the corner set by Albert Hass, since this part of the lane is in a cut section, however the fences appear to date back to the early 1900's. We accepted the position of the existing iron as the best available evidence of the position of the original corner.

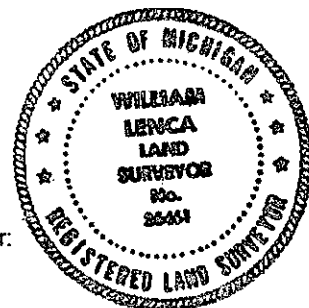

C. Description of monument for corner and accessories established to perpetuate locating the position of the corner:

Set 5/8" x 24" Iron Rod/3-1/4" dia. Alum. cap stamped for corner location:

4" dia. Cedar	S58°E	22.38 feet	Scr. NBT
7" dia. Cedar	S67°W	40.05 feet	Scr. NBT
9" dia. Cherry	N39°W	32.70 feet	Scr. NBT
5/8" x 24" Iron Rod/2" dia. Alum. cap marked "WITNESS MARKER"	North	18.92 feet	at Survey Sign Post
Metal Survey Sign Post	North	19.5 feet	

NOTE: All bearings are magnetic bearings. All distances are measured with steel tape. Distances to trees are to nail in side of tree.

Signed by William Lenca
Surveyor's Michigan License No. 26461

Date Oct. 13, 2000