

**SURVEY & REMONUMENTATION**

**JAN 09 2001**

**SECTION**

**LAND CORNER RECORDATION CERTIFICATE**  
Filing Requirement of Act 74, Mich. P.A. 1970

Approved by Menominee County  
Land Survey Remonumentation  
Peer Group Under Act 345 of  
P.A. Of 1990 On 7/13, 2000  
McAulis RLS  
Chairman

For corners in

MENOMINEE

(County)

Located In:

Corner Code #

1. Public Land Survey	T <u>35</u> N R <u>26</u> W	E-8
	T ___ R ___	_____
	T ___ R ___	_____
	T ___ R ___	_____
2. Property Controlling in Section	S ___ T ___ R ___	_____
	S ___ T ___ R ___	_____
3. Miscellaneous Property in Sec.	S ___ T ___ R ___	_____
	S ___ T ___ R ___	_____

*Book 6 Page 159*

RECEIVED FOR RECORD  
13 DEC 2000 10:16:09 A  
BARBARA MORRISON  
REGISTER OF DEEDS  
MENOMINEE, MI 49858

Register of Deeds Stamp & File Number

4. Lot No. \_\_\_\_\_, Recorded Plat \_\_\_\_\_  
5. Private Claims \_\_\_\_\_

I, William Lenca, in a field survey on Sep., 1900 do hereby state that under requirements of P.A. 74, Michigan P.A. of 1970, the corner points mentioned in lines 1 and 2 above were in conformance with regulations and rules therefore as required in the current manual of survey instructions of the United States Department of the Interior, Bureau of Land Management or by a decree of a Court of Law and /or that the corner points mentioned in lines 3, 4 and 5 above were in conformance with the rules of the Michigan Board of Land Surveyors or by a Decree of a Court of Law, established, re-established, monumented, recovered, found as expressed below:

NOTE: Not more than 2 corners, all in the same town and range, may be recorded on this certificate.


A	B	C	D	E	F	G	H	I	J	K	L	M
1												
2	6		5		4		3		2		1	
3												
4	7		8		9		10		11		12	
5												
6	18		17		16		15		14		13	
7												
8	19		20		21		22		23		24	
9												
10	30		29		28		27		26		25	
11												
12	31		32		33		34		35		36	
13												

A. Description of original monument and accessories and/or subsequent restoration:

- 1848: Original Survey by James H. Mullett - B.T.'s - Tamarack, 6" - N39°E - 4 lks.; Cedar, 6" - S33°W - 5 lks. All original evidence for this corner has been destroyed by County Road improvements.
- 1976: L.C.R.C. No. 130, Book 1, by George B. Wilson, RLS No. 17607 states "County Road Commision dug hole 10' x 10' x 6' deep. Found mark of old stake in gray sand just below original top soil. Set Concrete Monument, 4" dia. x 36" long with 1/2" iron rod inside." NBT'S: Cedar 3", N40°E, 48.36'; Cedar 4", N76°E, 28.36'.

B. Description of corner evidence found and/or method applied in restoring or reestablishing corner:

We recovered a 4 inch diameter concrete monument with 1/2 inch diameter iron pin in the center in location as described in L.C.R.C. No. 130, Book 1 (see part A). The corner falls in the centerline of county roads North - South - West and in line with an old fence running East. Wilson's record does not indicate if he verified the mark of the old stake as an original, so we accepted the position of the concrete monument as the best available evidence of the position of the original corner.

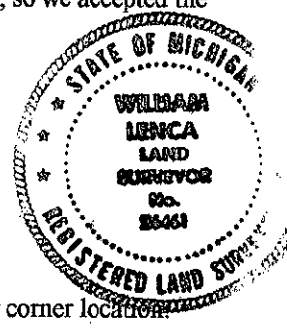

C. Description of monument for corner and accessories established to perpetuate locating the position of the corner:

- Set Monument Box over existing 4 inch diameter Concrete Monument - Set 3-1/4" dia. Alum. Cap stamped for corner location:
- |   |       |            |                    |
|---|-------|------------|--------------------|
| 20" dia. White Ash  | N29°E | 56.53 feet | Scr. NBT           |
| 5/8" x 24" Iron Rod/2" dia. Alum. cap marked "WITNESS MARKER" | East  | 24.20 feet | @ Survey Sign Post |
| 6" dia. Elm   | S47°E | 50.15 feet | Scr. NBT           |
| 5/8" x 24" Iron Rod/2" dia. Alum. cap marked "WITNESS MARKER" | S50°W | 37.61 feet | 1.0' S. of Rd Sign |
| Metal Survey Sign Post  | East  | 24.5 feet  |                    |

NOTE: All bearings are magnetic bearings. All distances are measured with steel tape. Distances to trees are to nail in side of tree.

Signed by William Lenca  
Surveyor's Michigan License No. 26461

Date Mar. 22, 2000

*154*