

SURVEY & REMONUMENTATION

JAN 09 2001

SECTION

LAND CORNER RECORDATION CERTIFICATE Filing Requirement of Act 74, Mich. P.A. 1970

Approved by Menominee County
Land Survey Remonumentation
Peer Group Under Act 345 of
P.A. of 1990 On 7/13, 2000
Mc Davis PLS
Chairman

Book 6 Page 155

For corners in <u>MENOMINEE</u> <small>(County)</small>	Located In:	Corner Code #	
1. Public Land Survey	T <u>35N</u> R <u>26W</u>	E-9	_____
	T _____ R _____	_____	_____
	T _____ R _____	_____	_____
	T _____ R _____	_____	_____
2. Property Controlling in Section	S _____ T _____ R _____	_____	_____
	S _____ T _____ R _____	_____	_____
3. Miscellaneous Property in Sec.	S _____ T _____ R _____	_____	_____
	S _____ T _____ R _____	_____	_____


RECEIVED FOR RECORD
13 DEC 2000 10:16:09 A
BARBARA MORRISON
REGISTER OF DEEDS
MENOMINEE, MI 49854

Register of Deeds Stamp & File Number

4. Lot No. _____, Recorded Plat _____
5. Private Claims _____

I, William Lenca, in a field survey on Sep., 1900 do hereby state that under requirements of P.A. 74, Michigan P.A. of 1970, the corner points mentioned in lines 1 and 2 above were in conformance with regulations and rules therefore as required in the current manual of survey instructions of the United States Department of the Interior, Bureau of Land Management or by a decree of a Court of Law and /or that the corner points mentioned in lines 3, 4 and 5 above were in conformance with the rules of the Michigan Board of Land Surveyors or by a Decree of a Court of Law; established, re-established, monumented, recovered, found as expressed below:

NOTE: Not more than 2 corners, all in the same town and range, may be recorded on this certificate.

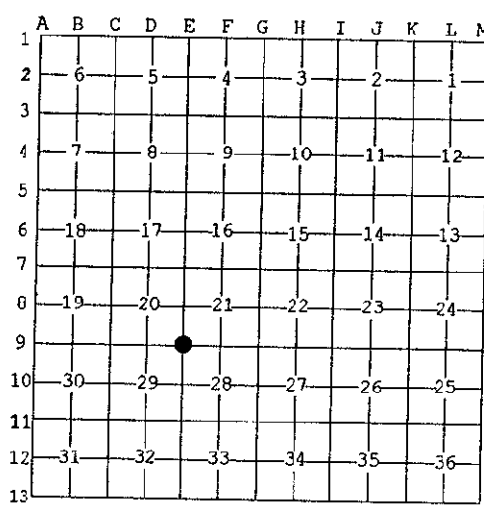

- A. Description of original monument and accessories and/or subsequent restoration:
- 1848: Original Survey by James H. Mullett - B.T.'s - Hemlock, 18" - N50°E - 27 lks.; Hemlock, 6" - N58°W - 30 lks.; All original evidence for this corner has been destroyed by County Road improvements.
 - 1968: Survey by Robert Olsen describes this corner as an Iron Pin in Road centerline.

B. Description of corner evidence found and/or method applied in restoring or reestablishing corner:
The Iron Pin described in Robert Olsen's 1968 Survey has been destroyed by County Road improvements. We re-set the corner in line with County Road centerlines East - West and North - South and accepted this location as the best available evidence of the position of the original corner.



- C. Description of monument for corner and accessories established to perpetuate locating the position of the corner:
- Set 5/8" x 24" Iron Rod/3-1/4" dia. Alum. cap stamped for corner location in Monument Box:
- | | | | |
|---|-------|------------|--------------------------|
| 5/8" x 24" Iron Rod/2" dia. Alum. cap marked "WITNESS MARKER" | N45°E | 57.60 feet | 1.0' W. of Tcl. Pedastal |
| 5/8" x 24" Iron Rod/2" dia. Alum. cap marked "WITNESS MARKER" | S45°E | 45.84 feet | 1.0' N. of Tcl. Pedastal |
| 5/8" x 24" Iron Rod/2" dia. Alum. cap marked "WITNESS MARKER" | S45°W | 51.47 feet | @ Survey Sign Post |
| 5/8" x 24" Iron Rod/2" dia. Alum. cap marked "WITNESS MARKER" | N44°W | 51.21 feet | 1.0' S. of Tcl. Pedastal |
| Metal Survey Sign Post | S45°W | 51.9 feet | |

NOTE: All bearings are magnetic bearings. All distances are measured with steel tape. Distances to trees are to nail in side of tree.

Signed by William Lenca Date Nov. 09, 2000
Surveyor's Michigan License No. 26461