

APR 06 1999

Approved by Menominee County
Land Survey Remonumentation
Peer Group Under Act 345 Of

P.A. Of 1990, On 12/14 1998

SECTION

LAND CORNER RECORDATION CERTIFICATE
Filing Requirement of Act 74, Mich. P.A. 1970

Mel Davis RLS
Chairman

For corners in
MENOMINEE
(County)

Located In: Corner Code #

- 1. Public Land Survey T 35N R 26W E-12
- 2. Property Controlling in Section S T R
- 3. Miscellaneous Property in Sec. S T R

RECEIVED FOR RECORD
99 JAN 27 PM 1:33
PAGE # 752 BK 5
BARBARA MORRISON
REGISTER OF DEEDS
MENOMINEE, MI 49858

Register of Deeds Stamp & File Number

- 4. Lot No. , Recorded Plat
- 5. Private Claims

	A	B	C	D	E	F	G	H	I	J	K	L	M
1													
2	6		5		4		3		2		1		
3													
4	7		8		9		10		11		12		
5													
6	10		17		16		15		14		13		
7													
8	19		20		21		22		23		24		
9													
10	30		29		28		27		26		25		
11													
12	31		32		33		34		35		36		
13													

I, William Lenca, in a field survey on June 18, 1998 do hereby state that under requirements of P.A. 74, Michigan P.A. of 1970, the corner points mentioned in lines 1 and 2 above were in conformance with regulations and rules therefore as required in the current manual of survey instructions of the United States Department of the Interior, Bureau of Land Management or by a decree of a Court of Law and/or that the corner points mentioned in lines 3, 4 and 5 above were in conformance with the rules of the Michigan Board of Land Surveyors or by a Decree of a Court of Law, established, re-established, monumented, recovered, found as expressed below:


NOTE: Not more than 2 corners, all in the same town and range, may be recorded on this certificate.

A. Description of original monument and accessories and/or subsequent restoration:
1848: Original Survey by James H. Mullett - B.T.'s - B. Ash, 10" - N89°W - 15 lks.; Cedar, 12" - S45°E - 08 lks. All original evidence for this corner has been destroyed by logging activities.

B. Description of corner evidence found and/or method applied in restoring or reestablishing corner:
After a careful search of the corner area, we found no evidence of the original corner accessories, or evidence of subsequent restoration. We therefore set the corner in line with an ancient fence North and by doubling the distance between the Northeast Corner and the North 1/16 Corner on the East line of Section 32, T35N - R26W. This location is accepted as the best available evidence of the position of the original corner.

C. Description of monument for corner and accessories established to perpetuate locating the position of the corner:
Set 2" dia. Aluminum Pipe 30" long/3-1/4" dia. Alum cap stamped for corner location:

12" dia. Cedar	N15°E	23.99 feet	Scr. NBT
5" dia. Cedar	S22°E	16.64 feet	Scr. NBT
14" dia. White Ash	S24°W	39.69 feet	Scr. NBT
7" dia. Cedar	N50°W	27.97 feet	Scr. NBT
Metal Survey Sign Post	North	1.0 feet	

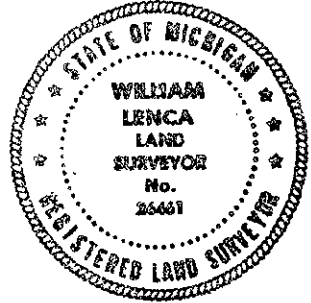

NOTE: All bearings are magnetic bearings. All distances are measured with steel tape. Distances to trees are to nail in side of tree.

Signed by William Lenca
Surveyor's Michigan License No. 26461

Date Aug. 25, 1998

752