

APR 06 1998

SECTION

LAND CORNER RECORDATION CERTIFICATE  
Filing Requirement of Act 74, Mich. P.A. 1970

Approved by Menominee County  
Land Survey Remuneration  
Peer Group Under Act 345 Of  
P.A. Of 1990 On 12/16 1998  
MEL DANK RLS  
Chairman

For corners in

MENOMINEE

(County)

Located In:

Corner Code #

1. Public Land Survey

T 35NR 26W E-13

T \_\_\_ R \_\_\_

T \_\_\_ R \_\_\_

T \_\_\_ R \_\_\_

T \_\_\_ R \_\_\_

2. Property Controlling  
in Section

S \_\_\_ T \_\_\_ R \_\_\_

S \_\_\_ T \_\_\_ R \_\_\_

3. Miscellaneous  
Property in Sec.

S \_\_\_ T \_\_\_ R \_\_\_

S \_\_\_ T \_\_\_ R \_\_\_

4. Lot No. \_\_\_\_\_, Recorded Plat \_\_\_\_\_

5. Private Claims \_\_\_\_\_

(SAME AS CORNER E-01, T34N - R26W)

I, William Lenca, in a field survey on Aug. 18, 19 98 do hereby state that under requirements of P.A. 74, Michigan P.A. of 1970, the corner points mentioned in lines 1 and 2 above were in conformance with regulations and rules therefore as required in the current manual of survey instructions of the United States Department of the Interior, Bureau of Land Management or by a decree of a Court of Law and/or that the corner points mentioned in lines 3, 4 and 5 above were in conformance with the rules of the Michigan Board of Land Surveyors or by a Decree of a Court of Law; established, re-established, monumented, recovered, found as expressed below:

NOTE: Not more than 2 corners, all in the same town and range, may be recorded on this certificate.

A. Description of original monument and accessories and/or subsequent restoration:

- 1847: Original Survey by Henry Floyd (Township Boundary) - B.T.'s - Sugar, 12" - N43°E - 23 lks.; Sugar, 15" - N38°W - 43 lks. All original evidence for this corner has been destroyed by county road improvements.
- 1848: Original Survey by James H. Mullett (Sectional Subdivision) - B.T.'s - Sugar, 16" - S34°W - 45 lks.; Birch, 10" - S36°E - 24 lks. All original evidence for this corner has been destroyed by county road improvements.

B. Description of corner evidence found and/or method applied in restoring or reestablishing corner:

We found a P.K. Nail in the centerline of County Roads East - West - South and in line with an ancient fence to the North. This location fits existing lines of occupation, and is accepted as the best available evidence of the position of the original corner.

C. Description of monument for corner and accessories established to perpetuate locating the position of the corner:

Set 5/8" x 24" Iron Rod/3-1/4" dia. Alum. cap stamped for corner location in Monument Box:

5/8" x 24" Iron Rod/2" dia. Alum. cap marked "WITNESS MARKER"	North	29.74 feet	@ Sign Post
35" dia. Maple (No blazes) Nail in N.W. side	N63°E	68.63 feet	
5/8" x 24" Iron Rod/2" dia. Alum. cap marked "WITNESS MARKER"	S52°E	44.98 feet	1' E. of Rd. Sign
7" dia. Norway Pine	N51°W	62.26 feet	Scr. NBT
Metal Survey Sign Post	North	30.2 feet	

NOTE: All bearings are magnetic bearings. All distances are measured with steel tape. Distances to trees are to nail in side of tree.


Signed by William Lenca  
Surveyor's Michigan License No. 26461

Date Aug. 25, 1998

RECEIVED FOR RECORD  
99 JAN 27 PM 4:32  
PAGE # 745, BKS  
BARBARA MORRISON  
REGISTER OF DEEDS  
MENOMINEE, MI 49859

Register of Deeds Stamp & File Number

	A	B	C	D	E	F	G	H	I	J	K	L	M
1													
2	6		5		4		3		2		1		
3													
4	7		8		9		10		11		12		
5													
6	18		17		16		15		14		13		
7													
8	19		20		21		22		23		24		
9													
10	30		29		28		27		26		25		
11													
12	31		32		33		34		35		36		
13													

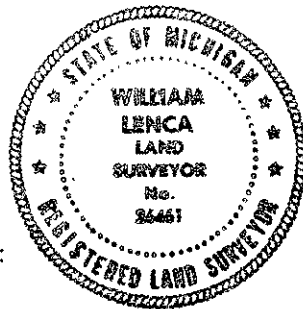

745