

SURVEY & REMONUMENTATION

JAN 09 2001

SECTION

LAND CORNER RECORDATION CERTIFICATE Filing Requirement of Act 74, Mich. P.A. 1970

Approved by Menominee County
Land Survey Remonumentation
Peer Group Under Act 345 of
P.A. of 1990 On 12/22, 2000
MEADIAN RLS
Chairman

For corners in MENOMINEE	Located In:	Corner Code #	
(County)			
1. Public Land Survey	T <u>35N</u> R <u>26W</u>	F-5	
	T ___ R ___		
	T ___ R ___		
	T ___ R ___		
2. Property Controlling in Section	S ___ T ___ R ___		
	S ___ T ___ R ___		
3. Miscellaneous Property in Sec.	S ___ T ___ R ___		
	S ___ T ___ R ___		

Bk. 6 Pg. 230


RECEIVED FOR RECORD
28 DEC 2000 2:31:31 PM
BARBARA MORRISON
REGISTER OF DEEDS
MENOMINEE, MI 49858

Register of Deeds Stamp & File Number

4. Lot No. _____, Recorded Plat _____
5. Private Claims _____

I, William Lenca, in a field survey on Jul., 1900 do hereby state that under requirements of P.A. 74, Michigan P.A. of 1970, the corner points mentioned in lines 1 and 2 above were in conformance with regulations and rules therefore as required in the current manual of survey instructions of the United States Department of the Interior, Bureau of Land Management or by a decree of a Court of Law and/or that the corner points mentioned in lines 3, 4 and 5 above were in conformance with the rules of the Michigan Board of Land Surveyors or by a Decree of a Court of Law, established, re-established, monumented, recovered, found as expressed below:

NOTE: Not more than 2 corners, all in the same town and range, may be recorded on this certificate.

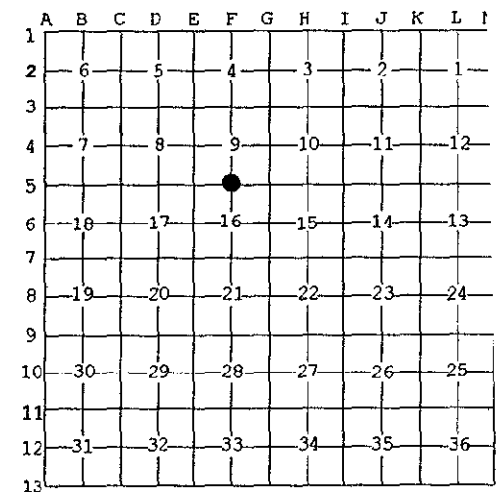


- A. Description of original monument and accessories and/or subsequent restoration:
- 1848: Original Survey by James H. Mullett - B.T.'s - Cedar, 6" - N68°W - 9 lks.; Cedar, 16" - S41°E - 11 lks.; All original evidence for this corner has been destroyed by County Road improvements.
 - 1965: Plat of Survey by Robert Olsen, RLS No. 10700, shows this corner as it relates to old fences 1/4 mile East and West. The corner monument is not described.

B. Description of corner evidence found and/or method applied in restoring or reestablishing corner:
Set Corner in centerline of asphalt surface East - West County Road in line with an old fence line running South. This position fits well with old established fence lines 1/4 mile East and 1/4 mile West and with Robert Olsen's record measurements to these fences, and is accepted as the best available evidence of the position of the original corner.

C. Description of monument for corner and accessories established to perpetuate locating the position of the corner:
Set 5/8" x 24" Iron Rod/3-1/4" dia. Alum. cap stamped for corner location in Monument Box:

6" dia. Tamarack	N40°E	55.25 feet	Scr. NBT
9" dia. Elm	S43°E	37.00 feet	Scr. NBT
8" dia. Yellow Birch	S34°W	65.55 feet	Scr. NBT
5" dia. Tamarack	N38°W	74.00 feet	Scr. NBT
Metal Survey Sign Post	South	31.5 feet	

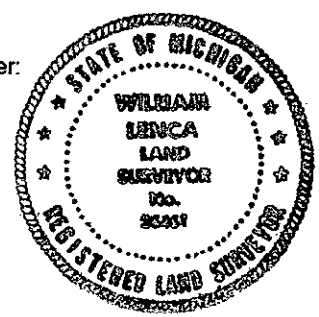

NOTE: All bearings are magnetic bearings. All distances are measured with steel tape. Distances to trees are to nail in side of tree.

Signed by William Lenca
Surveyor's Michigan License No. 26461

Date Aug. 8, 2000