

**SURVEY & REMONUMENTATION**

JAN 09 2001

**SECTION**

**LAND CORNER RECORDATION CERTIFICATE**  
Filing Requirement of Act 74, Mich. P.A. 1970

Approved by Menominee County  
Land Survey Remonumentation  
Peer Group Under Act 345 of  
P.A. Of 1990 On 7/13, 2000  
William RLS  
Chairman

*Book 6 Page 158*

For corners in <u>MENOMINEE</u> (County)	Located In:	Corner Code #
1. Public Land Survey	T <u>35</u> N R <u>26</u> W	F-9
	T _____ R _____	_____
	T _____ R _____	_____
	T _____ R _____	_____
2. Property Controlling in Section	S _____ T _____ R _____	_____
	S _____ T _____ R _____	_____
3. Miscellaneous Property in Sec.	S _____ T _____ R _____	_____
	S _____ T _____ R _____	_____


RECEIVED FOR RECORD  
13 DEC 2000 10:16:09 A  
BARBARA MORRISON  
REGISTER OF DEEDS  
MENOMINEE MI 49854

Register of Deeds Stamp & File Number

4. Lot No. \_\_\_\_\_, Recorded Plat \_\_\_\_\_  
5. Private Claims \_\_\_\_\_

I, William Lenca, in a field survey on Sep., 1900 do hereby state that under requirements of P.A. 74, Michigan P.A. of 1970, the corner points mentioned in lines 1 and 2 above were in conformance with regulations and rules therefore as required in the current manual of survey instructions of the United States Department of the Interior, Bureau of Land Management or by a decree of a Court of Law and /or that the corner points mentioned in lines 3, 4 and 5 above were in conformance with the rules of the Michigan Board of Land Surveyors or by a Decree of a Court of Law; established, re-established, monumented, recovered, found as expressed below:

NOTE: Not more than 2 corners, all in the same town and range, may be recorded on this certificate.

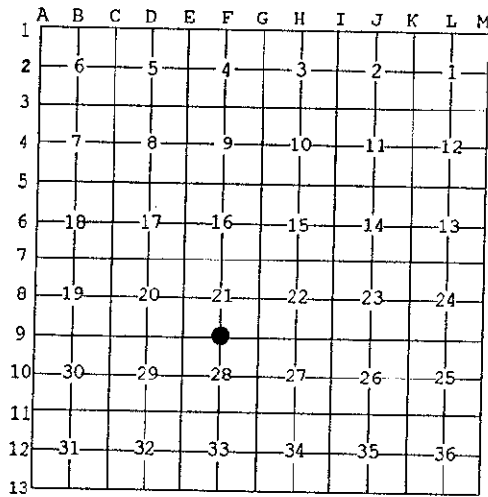

**A. Description of original monument and accessories and/or subsequent restoration:**

- 1848: Original Survey by James H. Mullett - B.T.'s - Sugar, 18" - S66°E - 7 lks.; Hemlock, 30" - N43°W - 23 lks.; All original evidence for this corner has been destroyed by County Road improvements.
- 1970: Survey by Robert Olsen, RLS No. 10700, shows this corner in the centerline of county roads East - West and South. No description of the corner monument is given.
- 1996: Plat of Survey by William Lenca, RLS No. 26461, shows this corner as it relates to other corners in the SE1/4 of Section 21, T35N-R26W.

**B. Description of corner evidence found and/or method applied in restoring or reestablishing corner:**

Found a Railroad Spike in the centerline of asphalt surface roads running East - West and South, and in line with an old fence line running North. This position fits with the location shown in the 1970 Survey and the 1996 Survey described in Part A above and fits well with measurements to an old established fence line 1/4 mile West and with the centerline of a county road 1/4 mile East, and is accepted as the best available evidence of the position of the original corner.

**C. Description of monument for corner and accessories established to perpetuate locating the position of the corner:**

Set 5/8" x 24" Iron Rod/3-1/4" dia. Alum. cap stamped for corner location in Monument Box:

5/8" x 24" Iron Rod/Plastic Ident. cap (MI 26461/WI 1569)	N27°E	39.32 feet	1.0' W. of PP
5/8" x 24" Iron Rod/2" dia. Alum. cap marked "WITNESS MARKER"	S44°E	53.48 feet	1.0' W. of PP
5/8" x 24" Iron Rod/2" dia. Alum. cap marked "WITNESS MARKER"	S44°W	52.48 feet	1.0' N. Cor. Fc. Post
5/8" x 24" Iron Rod/Plastic Ident. cap (MI 26461/WI 1569)	N40°W	45.86 feet	1.0' W. of Tel. Pedastal
Metal Survey Sign Post	North	32.8 feet	

NOTE: All bearings are magnetic bearings. All distances are measured with steel tape. Distances to trees are to nail in side of tree.

Signed by William Lenca  
Surveyor's Michigan License No. 26461

Date Nov. 9, 2000

