

**SURVEY &  
REMONUMENTATION**

**JAN 09 2001**

**SECTION**

**LAND CORNER RECORDATION CERTIFICATE  
Filing Requirement of Act 74, Mich. P.A. 1970**

Approved by Menominee County  
Land Survey Remonumentation  
Peer Group Under Act 345 of  
P.A. of 1990 On 7/13, 2000  
Mike Davis PLS  
Chairman

For corners in

MENOMINEE  
(County)

Located In:

Corner Code #

- |                                       |                            |       |
|---------------------------------------|----------------------------|-------|
| 1. Public Land Survey                 | T <u>35</u> NR <u>26</u> W | H-3   |
|                                       | T ___ R ___                | _____ |
|                                       | T ___ R ___                | _____ |
|                                       | T ___ R ___                | _____ |
| 2. Property Controlling<br>in Section | S ___ T ___ R ___          | _____ |
|                                       | S ___ T ___ R ___          | _____ |
| 3. Miscellaneous<br>Property in Sec.  | S ___ T ___ R ___          | _____ |
|                                       | S ___ T ___ R ___          | _____ |

*Book 6 Page 169*


RECEIVED FOR RECORD  
13 DEC 2000 10:16:09 A  
BARBARA MORRISON  
REGISTER OF DEEDS  
MENOMINEE, MI 49858

Register of Deeds Stamp & File Number

4. Lot No. \_\_\_\_\_, Recorded Plat \_\_\_\_\_  
5. Private Claims \_\_\_\_\_

I, William Lenca, in a field survey on Jul., 1900 do hereby state that under requirements of P.A. 74, Michigan P.A. of 1970, the corner points mentioned in lines 1 and 2 above were in conformance with regulations and rules therefore as required in the current manual of survey instructions of the United States Department of the Interior, Bureau of Land Management or by a decree of a Court of Law and /or that the corner points mentioned in lines 3, 4 and 5 above were in conformance with the rules of the Michigan Board of Land Surveyors or by a Decree of a Court of Law; established, re-established, monumented, recovered, found as expressed below:

NOTE: Not more than 2 corners, all in the same town and range, may be recorded on this certificate.

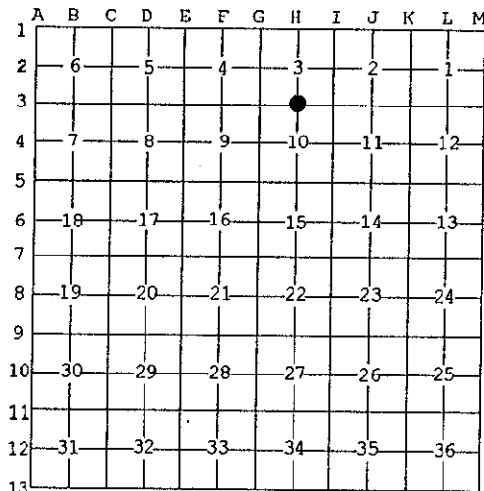

A. Description of original monument and accessories and/or subsequent restoration:

1848: Original Survey by James H. Mullett - B.T.'s - Hemlock, 10" - N62°E - 17 lks.; Hemlock, 10" - S65°W - 6 lks. All original evidence for this corner has been destroyed by clearing and farming activities.

B. Description of corner evidence found and/or method applied in restoring or reestablishing corner:

Found a 5/8 inch x 24 inch iron rod with plastic identification cap set at old fence corner - fences run East - West and South. According to my private field notes, this iron was set for control in a 1990 Survey in Section 3, T35N - R26W. This position fits well with measurements to corners 1/2 mile East and 1/2 mile West, and is accepted as the best available evidence of the position of the original corner.



C. Description of monument for corner and accessories established to perpetuate locating the position of the corner:

Set 3/4" dia. x 4' long aluminum rod/3-1/4" dia. Alum. cap stamped for corner.

- |                        |       |            |          |
|------------------------|-------|------------|----------|
| Twin 9" dia. Beech     | N88°E | 53.95 feet | Scr. NBT |
| 6" dia. Cherry         | S08°E | 90.82 feet | Scr. NBT |
| 6" dia. Cherry         | S75°W | 14.22 feet | Scr. NBT |
| Metal Survey Sign Post | North | 0.5 feet   |          |
| Nothing Else Nearby    |       |            |          |

NOTE: All bearings are magnetic bearings. All distances are measured with steel tape. Distances to trees are to nail in side of tree.

Signed by William Lenca  
Surveyor's Michigan License No. 26461

Date Aug. 8, 2000