

SURVEY & REMONUMENTATION

JAN 09 2001

SECTION

LAND CORNER RECORDATION CERTIFICATE
Filing Requirement of Act 74, Mich. P.A. 1970

Approved by Menominee County
Land Survey Remonumentation
Peer Group Under Act 345 of
P.A. of 1990 On 12/22, 2000
Mr. David RLS
Chairman

Bk. 6 Pg. 235


For corners in	Located in:	Corner Code #
<u>MENOMINEE</u> (County)		
1. Public Land Survey	T <u>35N</u> R <u>26W</u>	<u>H-5</u>
	T ___ R ___	_____
	T ___ R ___	_____
	T ___ R ___	_____
2. Property Controlling in Section	S ___ T ___ R ___	_____
	S ___ T ___ R ___	_____
3. Miscellaneous Property in Sec.	S ___ T ___ R ___	_____
	S ___ T ___ R ___	_____

RECEIVED FOR RECORD
28 DEC 2000 2:31:31 PM
BARBARA MORRISON
REGISTER OF DEEDS
MENOMINEE, MI 49858

Register of Deeds Stamp & File Number

4. Lot No. _____, Recorded Plat _____
5. Private Claims _____

I, William Lenca, in a field survey on Jul., 1900 do hereby state that under requirements of P.A. 74, Michigan P.A. of 1970, the corner points mentioned in lines 1 and 2 above were in conformance with regulations and rules therefore as required in the current manual of survey instructions of the United States Department of the Interior, Bureau of Land Management or by a decree of a Court of Law and /or that the corner points mentioned in lines 3, 4 and 5 above were in conformance with the rules of the Michigan Board of Land Surveyors or by a Decree of a Court of Law; established, re-established, monumented, recovered, found as expressed below:

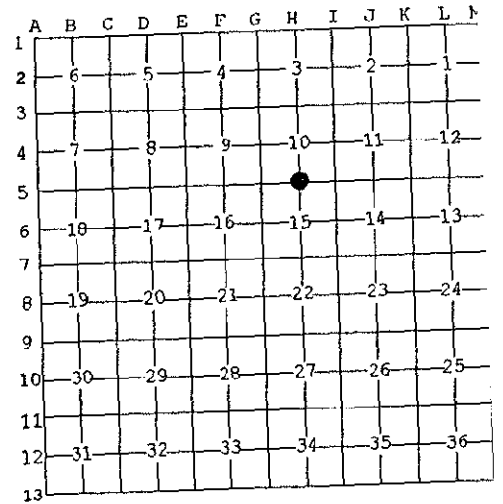

NOTE: Not more than 2 corners, all in the same town and range, may be recorded on this certificate.

A. Description of original monument and accessories and/or subsequent restoration:

- 1848: Original Survey by James H. Mullett - B.T.'s - Spruce, 4" - N2°W - 9 lks.; Spruce, 7" - S69°E - 7 lks. All original evidence for this corner has been destroyed by County Road improvements.
1991: L.C.R.C. No. 910, Book 3, by William Lenca, RLS No. 26461 states "Set Railroad Spike in centerline of E-W county road & in line with old fence south. TIES: Nail in 5" W. Birch, S51°E, 59.71'; Nail in 9" Tamarack, S09°W, 36.20'; Nail in 7" Cedar, S48°W, 54.83'; Nail in Cedar 6", N32°W, 49.82'.

B. Description of corner evidence found and/or method applied in restoring or reestablishing corner:

Found a railroad spike in the centerline of an East - West County Road and in line with an old fence running South and 4 B.T.'s as described in L.C.R.C. No. 910 (see part A) fitting this corner. This position fits well with long standing lines of occupation, has been used as control for Surveys in the area, and is accepted as the best available evidence of the position of the original corner.

C. Description of monument for corner and accessories established to perpetuate locating the position of the corner:

Set 5/8" x 24" Iron Rod/3-1/4" dia. Alum. cap stamped for corner location in Monument Box:

6" dia. Elm	N43°E	86.82 feet	Scr. NBT
6" dia. Cedar	S57°E	61.89 feet	Scr. NBT
8" dia. Cedar (Existing)	S48°W	54.83 feet	Has X Cut in Blazes
7" dia. Cedar (Existing)	N32°W	49.76 feet	Has X Cut in Blazes
Metal Survey Sign Post	S07°E	28.3 feet	



NOTE: All bearings are magnetic bearings. All distances are measured with steel tape. Distances to trees are to nail in side of tree.

Signed by William Lenca
Surveyor's Michigan License No. 26461

Date Aug. 8, 2000