

SURVEY & REMONUMENTATION

JAN 09 2001

SECTION

LAND CORNER RECORDATION CERTIFICATE
Filing Requirement of Act 74, Mich. P.A. 1970

Approved by Menominee County
Land Survey Remonumentation
Peer Group Under Act 345 of
P.A. of 1990 On 7/13, 2002
Mike Davis RLS
Chairman

For corners in
MENOMINEE
(County)

Located in: Corner Code #

- | | | |
|------------------------------------|-------------------------------------|------------|
| 1. Public Land Survey | T <u>35N</u> R <u>26W</u> | <u>H-7</u> |
| | T <u> </u> R <u> </u> | <u> </u> |
| | T <u> </u> R <u> </u> | <u> </u> |
| | T <u> </u> R <u> </u> | <u> </u> |
| 2. Property Controlling in Section | S <u> </u> T <u> </u> R <u> </u> | <u> </u> |
| | S <u> </u> T <u> </u> R <u> </u> | <u> </u> |
| 3. Miscellaneous Property in Sec. | S <u> </u> T <u> </u> R <u> </u> | <u> </u> |
| | S <u> </u> T <u> </u> R <u> </u> | <u> </u> |


Book 6 Page 170

RECEIVED FOR RECORD
13 DEC 2000 10:16:09 A
BARBARA MORRISON
REGISTER OF DEEDS
MENOMINEE, MI 49858

Register of Deeds Stamp & File Number

4. Lot No. _____, Recorded Plat _____
5. Private Claims _____

I, William Lenca, in a field survey on Sep., 1900 do hereby state that under requirements of P.A. 74, Michigan P.A. of 1970, the corner points mentioned in lines 1 and 2 above were in conformance with regulations and rules therefore as required in the current manual of survey instructions of the United States Department of the Interior, Bureau of Land Management or by a decree of a Court of Law and /or that the corner points mentioned in lines 3, 4 and 5 above were in conformance with the rules of the Michigan Board of Land Surveyors or by a Decree of a Court of Law; established, re-established, monumented, recovered, found as expressed below:

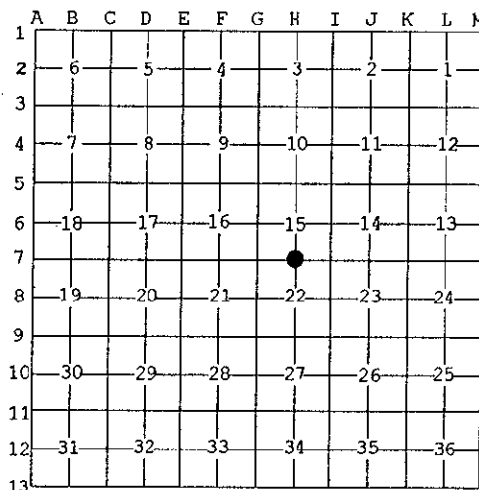

NOTE: Not more than 2 corners, all in the same town and range, may be recorded on this certificate.

A. Description of original monument and accessories and/or subsequent restoration:

- 1848: Original Survey by James H. Mullett - B.T.'s - Beech, 8" - N34°E - 24 lks.; Beech, 4" - S4°W - 13 lks. All original evidence for this corner has been destroyed by County Road improvements.
1991: L.C.R.C. No. 910, Book 3, by William Lenca, RLS No. 26461 states "Set Railroad Spike in centerline of E-W county road & in line with old fence running south. This position fits closely with midway position between section corners East and West." TIES: Nail in 8" Basswood, N78°E, 93.30'; Nail in 5" Elm, S19°E, 34.23'; Nail in 26" Maple, S48°E, 59.38'; Nail in Power Pole, N48°W, 54.53'.

B. Description of corner evidence found and/or method applied in restoring or reestablishing corner:

Found Railroad Spike in the centerline of an East - West County Road and in line with an old fence running South. This position matches with measurements to the ties described in L.C.R.C. No. 910 (see part A), fits well with measurements to Corners 1/2 mile East (2543.01 feet) and 1/2 mile West (2542.33 feet), has been used as control for surveys in the area, and is accepted as the best available evidence of the position of the original corner.

C. Description of monument for corner and accessories established to perpetuate locating the position of the corner:

Set 5/8" x 24" Iron Rod/3-1/4" dia. Alum. cap stamped for corner location in Monument Box:

9" dia. Basswood	N76°E	92.95 feet	Scr. NBT
26" dia. Maple	S48°E	59.31 feet	
8" dia. Elm	S19°E	34.26 feet	Scr. NBT
5/8" x 24" Iron Rod/2" dia. Alum. cap marked "WITNESS MARKER"	N53°W	53.10 feet	1.0' E of Power Pole
Metal Survey Sign Post	South	32.8 feet	

NOTE: All bearings are magnetic bearings. All distances are measured with steel tape. Distances to trees are to nail in side of tree.

Signed by William Lenca
Surveyor's Michigan License No. 26461

Date Nov. 16, 2000

