

SURVEY & REMONUMENTATION

JAN 09 2001

SECTION

LAND CORNER RECORDATION CERTIFICATE
Filing Requirement of Act 74, Mich. P.A. 1970

Approved by Menominee County
Land Survey Remonumentation
Peer Group Under Act 345 of
P.A. Of 1990 On 7/13, 2000
W. Davis RLS
Chairman

Book 6 Page 171

MENOMINEE (County)	Located In:	Corner Code #
1. Public Land Survey	T 35NR 26W	I-1
	T R	
	T R	
	T R	
2. Property Controlling in Section	S T R	
	S T R	
3. Miscellaneous Property in Sec.	S T R	
	S T R	

RECEIVED FOR RECORD
13 DEC 2000 10:16:08 A
BARBARA MORRISON
REGISTER OF DEEDS
MENOMINEE, MI 49858

Register of Deeds Stamp & File Number

4. Lot No. _____, Recorded Plat _____

5. Private Claims _____

SAME AS CORNER I-13, T36N-R26W

I, William Lenca, in a field survey on Jul., 1900 do hereby state that under requirements of P.A. 74, Michigan P.A. of 1970, the corner points mentioned in lines 1 and 2 above were in conformance with regulations and rules therefore as required in the current manual of survey instructions of the United States Department of the Interior, Bureau of Land Management or by a decree of a Court of Law and/or that the corner points mentioned in lines 3, 4 and 5 above were in conformance with the rules of the Michigan Board of Land Surveyors or by a Decree of a Court of Law, established, re-established, monumented, recovered, found as expressed below:

NOTE: Not more than 2 corners, all in the same town and range, may be recorded on this certificate.


	A	B	C	D	E	F	G	H	I	J	K	L	M
1													
2	6		5		4		3		2		1		
3													
4	7		8		9		10		11		12		
5													
6	18		17		16		15		14		13		
7													
8	19		20		21		22		23		24		
9													
10	30		29		28		27		26		25		
11													
12	31		32		33		34		35		36		
13													

A. Description of original monument and accessories and/or subsequent restoration:

- 1848: Original Survey by James H. Mullett - B.T.'s - Beech, 6" - N67°W - 34 lks.; Beech, 7" - N46°E - 38 lks.; Beech, 6" - N67°W - 36 lks.; Beech, 7" - N46°E - 38 lks. All original evidence for this corner has been destroyed by County Road improvements.
- 1981: L.C.R.C. No. 266, (Bk. 1) by George B. Wilson, RLS No. 17607 states "Lost Corner, re-set RR Spike using road centerlines. Will re-set Monument Box in summer." TIES: Telephone sign, S32°W, 83.2'; Telephone Box, S74°E, 88.75'; Men. Cty. Project Marker, S40°E, 56.60'.

B. Description of corner evidence found and/or method applied in restoring or reestablishing corner:

Found Railroad Spike in centerline of 4 way county road intersection matching ties as described in L.C.R.C. No. 266 (see part A). This corner position has been accepted and used by local surveyors for over 19 years, and is accepted as the best available evidence of the position of the original corner.

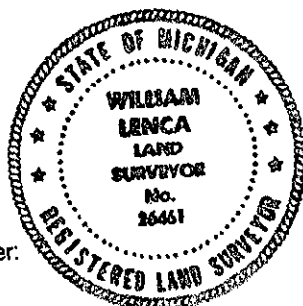

C. Description of monument for corner and accessories established to perpetuate locating the position of the corner:

Set 5/8" x 24" Iron Rod/3-1/4" dia. Alum. cap stamped for corner location in Monument Box:

5/8" x 24" Iron Rod/2" dia. Alum. cap marked "WITNESS MARKER"	N47°E	46.24 feet	@ Survey Sign Post
16" dia. Hard Maple	S39°E	90.39 feet	Scr. NBT
5/8" x 24" Iron Rod/2" dia. Alum. cap marked "WITNESS MARKER"	S21°W	83.06 feet	0.7' E of Tel. Cable Sign
14" dia. Norway Pine	N33°W	70.03 feet	Scr. NBT
Metal Survey Sign Post	N47°E	46.8 feet	

NOTE: All bearings are magnetic bearings. All distances are measured with steel tape. Distances to trees are to nail in side of tree.

Signed by William Lenca
Surveyor's Michigan License No. 26461

Date Aug. 8, 2000