SURVEY &
REMONUMENTATION

FEB 11 1998

Approved by Menominee County
Land Survey Remonumentation
Peer Group Under Act 345 Of
P.A. Of 1990 On 12/18 199 7
Chairman

SECTION

LAND CORNER RECORDATION CERTIFICATE
Filing Requirement of Act 74, Mich. P.A. 1970

For corners in
MENOMINEE
(County)

	Located In:	Corner Code #
1. Public Land Survey	T35N R 26W	I-04
	T___ R___	
	T___ R___	
	T___ R___	
2. Property Controlling	S___ T___ R___	
in Section	S___ T___ R___	
3. Miscellaneous	S___ T___ R___	
Property in Sec.	S___ T___ R___	

RECEIVED FOR RECORD
97 DEC 22 AM 11:25
BARBARA MCPHERSON
REGISTER OF DEEDS
MENOMINEE COUNTY
PAGE # 570, BK 5

Register of Deeds Stamp & File Number

4. Lot No. _____ , Recorded Plat _____
5. Private Claims _____

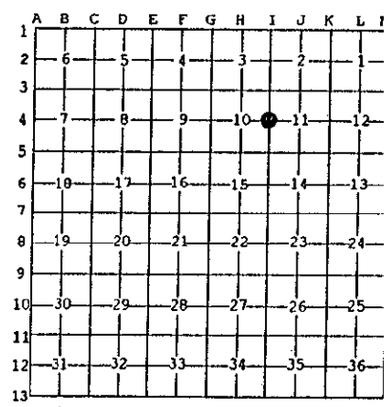

I, William Lenca, in a field survey on Nov. 06, 19 97 do hereby state that under requirements of P.A. 74, Michigan P.A. of 1970, the corner points mentioned in lines 1 and 2 above were in conformance with regulations and rules therefore as required in the current manual of survey instructions of the United States Department of the Interior, Bureau of Land Management or by a decree of a Court of Law and /or that the corner points mentioned in lines 3, 4 and 5 above were in conformance with the rules of the Michigan Board of Land Surveyors or by a Decree of a Court of Law; established, re-established, monumented, recovered, found as expressed below:

NOTE: Not more than 2 corners, all in the same town and range, may be recorded on this certificate.

A. Description of original monument and accessories and/or subsequent restoration:

1848: Original Survey by James H. Mullett - B.T.'s - Cedar, 6" - S50°W - 13 lks.; Hemlock, 12" - N10°E - 13 lks. All original evidence for this corner has been destroyed by farming activities.

B. Description of corner evidence found and/or method applied in restoring or reestablishing corner:

We computed the single proportional location for this corner, traversed in to it and searched the area. We found remnants of an ancient fence corner near our single proportional location. The fence corner is 15.15 feet East and 2.56 feet North of the proportional location. This evidence supports the fact that the entire West half of this section measures long. The West half mile on the North line of this section is/84 feet long while the West half mile on the South Line is 61 feet long. We accepted the ancient fence corner as the best available evidence of the position of the original corner.

C. Description of monument for corner and accessories established to perpetuate locating the position of the corner:

Set 5/8" x 24" long Iron rod/3-1/4" dia. Alum. cap (in rocks) stamped for corner:

STATE OF MICHIGAN
WILLIAM LENCA
LAND SURVEYOR
No. 26461
REGISTERED LAND SURVEYOR

5" dia. Cedar	N03°E	32.95 feet	Scr. NBT
10" dia. Cedar	N86°E	16.76 feet	Scr. NBT
11" dia. Cedar	S11°E	13.15 feet	Scr. NBT
8" dia Cedar	S80°W	11.17 feet	Scr. NBT
Metal Survey Sign Post	South	0.9 feet	

NOTE: All bearings are magnetic bearings. All distances are measured with steel tape. Distances to trees are to nail in side of tree.

Signed by William Lenca Date Nov. 04, 1997
Surveyor's Michigan License No. 26461

FORM APPROVED BY MICHIGAN STATE BOARD OF PROFESSIONAL SURVEYORS, JAN. 28, 1971
REVISED MAY 14, 1975
REVISED JAN., 1983
REVISED OCT., 1995