

JAN 09 2001

SECTION

LAND CORNER RECORDATION CERTIFICATE  
Filing Requirement of Act 74, Mich. P.A. 1970

Approved by Menominee County  
Land Survey Remonumentation  
Peer Group Under Act 345 of  
P.A. Of 1990 On 7/13, 2000  
Mr. David RLS  
Chairman

For corners in  
MENOMINEE  
(County)

Located In: Corner Code #

1. Public Land Survey	T	35N	R	26W	I-9
	T		R		
	T		R		
	T		R		
2. Property Controlling in Section	S		T	R	
	S		T	R	
3. Miscellaneous Property in Sec.	S		T	R	
	S		T	R	

Book 6 Page 175


RECEIVED FOR RECORD  
13 DEC 2000 10:16:09 A  
BARBARA MORRISON  
REGISTER OF DEEDS  
MENOMINEE, MI 49858

Register of Deeds Stamp & File Number

4. Lot No. \_\_\_\_\_, Recorded Plat \_\_\_\_\_  
5. Private Claims \_\_\_\_\_

I, William Lenca, in a field survey on Sep., 1900 do hereby state that under requirements of P.A. 74, Michigan P.A. of 1970, the corner points mentioned in lines 1 and 2 above were in conformance with regulations and rules therefore as required in the current manual of survey instructions of the United States Department of the Interior, Bureau of Land Management or by a decree of a Court of Law and/or that the corner points mentioned in lines 3, 4 and 5 above were in conformance with the rules of the Michigan Board of Land Surveyors or by a Decree of a Court of Law; established, re-established, monumented, recovered, found as expressed below:

NOTE: Not more than 2 corners, all in the same town and range, may be recorded on this certificate.

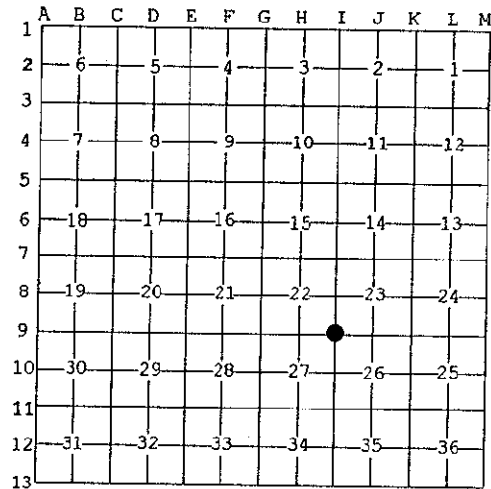

A. Description of original monument and accessories and/or subsequent restoration:

- 1848: Original Survey by James H. Mullett - B.T.'s - Cedar, 10" - N70°E - 30 lks.; Hemlock, 10" - S35°W - 14 lks. All original evidence for this corner has been destroyed by County Road improvements.
- 1975: L.C.R.C. No. 117, Book 1, by David B. Babbitt, RLS No. 21558 states "Set 1/2" pipe with plastic RLS cap from Co. Road witness to road P.I. and centerline of road E-W-N. Could find no other evidence of the Sec. Corner location." TIES: West end of c.m.p., N23°W, 50.3'; East end of c.m.p., N14°E, 47.8'} culvert.

B. Description of corner evidence found and/or method applied in restoring or reestablishing corner:

Found a 1/2 inch diameter iron pipe in place in line with the centerline of County Roads running East - West and North, as described in L.C.R.C. No. 117 (see part A). This corner position fits well with existing occupation, has been used as control for surveys in the area for over 25 years, and is accepted as the best available evidence of the position of the original corner.

C. Description of monument for corner and accessories established to perpetuate locating the position of the corner:

Set 5/8" x 24" Iron Rod/3-1/4" dia. Alum. cap stamped for corner location in Monument Box:

Twin 8" dia. Elm	N35°E	60.71 feet	Scr. NBT
5/8" x 24" Iron Rod/2" dia. Alum. cap marked "WITNESS MARKER"	S61°W	47.78 feet	1.0' W. of Anchor Pole
5/8" x 24" Iron Rod/2" dia. Alum. cap marked "WITNESS MARKER"	N50°W	49.20 feet	1.0' W. of Power Pole
5/8" x 24" Iron Rod/2" dia. Alum. cap marked "WITNESS MARKER"	South	26.87 feet	@ Survey sign post
Metal Survey Sign Post	South	28.1 feet	



NOTE: All bearings are magnetic bearings. All distances are measured with steel tape. Distances to trees are to nail in side of tree.

Signed by William Lenca  
Surveyor's Michigan License No. 26461

Date Nov. 16, 2000

17.5