

**SURVEY & REMONUMENTATION**

**JAN 09 2001**

**SECTION**

**LAND CORNER RECORDATION CERTIFICATE**  
Filing Requirement of Act 74, Mich. P.A. 1970

Approved by Menominee County  
Land Survey Remonumentation  
Peer Group Under Act 345 of  
P.A. Of 1990 On 2/13, 2000  
David Babbitt RLS  
Chairman

*Book 6 Page 177*

RECEIVED FOR RECORD  
13 DEC 2000 10:16:09 A  
BARBARA MORRISON  
REGISTER OF DEEDS  
MENOMINEE, MI 49858

Register of Deeds Stamp & File Number

For corners in MENOMINEE (County)

Located In: \_\_\_\_\_ Corner Code # \_\_\_\_\_


1. Public Land Survey T 35NR 26W J-7  
T \_\_\_\_\_ R \_\_\_\_\_  
T \_\_\_\_\_ R \_\_\_\_\_  
T \_\_\_\_\_ R \_\_\_\_\_

2. Property Controlling in Section S \_\_\_\_\_ T \_\_\_\_\_ R \_\_\_\_\_  
S \_\_\_\_\_ T \_\_\_\_\_ R \_\_\_\_\_

3. Miscellaneous Property in Sec. S \_\_\_\_\_ T \_\_\_\_\_ R \_\_\_\_\_  
S \_\_\_\_\_ T \_\_\_\_\_ R \_\_\_\_\_

4. Lot No. \_\_\_\_\_, Recorded Plat \_\_\_\_\_

5. Private Claims \_\_\_\_\_

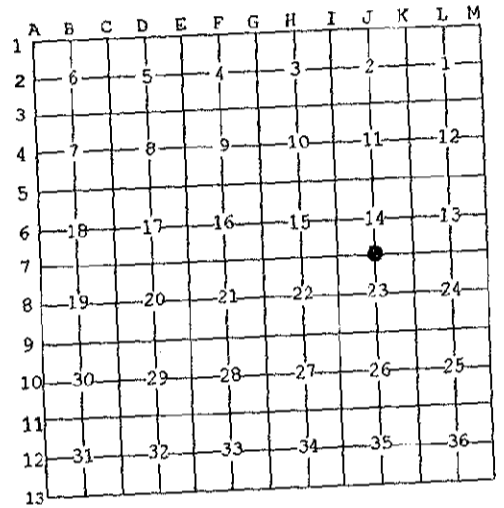

I, William Lenca, in a field survey on Sep., 1900 do hereby state that under requirements of P.A. 74, Michigan P.A. of 1970, the corner points mentioned in lines 1 and 2 above were in conformance with regulations and rules therefore as required in the current manual of survey instructions of the United States Department of the Interior, Bureau of Land Management or by a decree of a Court of Law and/or that the corner points mentioned in lines 3, 4 and 5 above were in conformance with the rules of the Michigan Board of Land Surveyors or by a Decree of a Court of Law; established, re-established, monumented, recovered, found as expressed below:

NOTE: Not more than 2 corners, all in the same town and range, may be recorded on this certificate.

A. Description of original monument and accessories and/or subsequent restoration:

- 1848: Original Survey by James H. Mullett - B.T.'s - Beech, 6" - S31°W - 26 lks.; Beech, 4" - N34°E - 12 lks.; All original evidence for this corner has been destroyed by County Road improvements.
- 1975: L.C.R.C. No. 121, Book 1, by David B. Babbitt, RLS No. 21558 states "No mon. found. Set 1" iron pipe with 4" aluminum cap at intersection of roads E-W-S and in line with old fence north as being the best evidence for the proper location of this corner." TIES: Elm 18", S20°W, 73.4'; Stop Sign, S26°E, 49.2'.

B. Description of corner evidence found and/or method applied in restoring or reestablishing corner:

Found 1 inch diameter iron pipe with standard DNR 4 inch diameter aluminum cap stamped for corner location in place as described in L.C.R.C. No. 121 (see part A). The corner falls in the centerline of county roads running East - West and South, and in line with old fence line running North. This corner has been used by local surveyors for at least 25 years, and is accepted as the best available evidence of the position of the original corner.



C. Description of monument for corner and accessories established to perpetuate locating the position of the corner:

Accepted Existing 1" dia. Iron Pipe/4" Alum. Cap stamped for corner location.

5/8" x 24" Iron Rod/2" dia. Alum. cap marked "WITNESS MARKER"	North	32.31 feet	@ Survey Sign Post
5/8" x 24" Iron Rod/2" dia. Alum. cap marked "WITNESS MARKER"	S28°E	49.83 feet	1.0' E. of Stop Sign Post
5/8" x 24" Iron Rod/2" dia. Alum. cap marked "WITNESS MARKER"	N49°W	43.01 feet	1.0' W. of Tel. Pedastal
Metal Survey Sign Post	North	32.9 feet	
Nothing Else Nearby			

NOTE: All bearings are magnetic bearings. All distances are measured with steel tape. Distances to trees are to nail in side of tree.

Signed by William Lenca  
Surveyor's Michigan License No. 26461

Date Nov. 16, 2000