

# SURVEY & REMONUMENTATION

JAN 09 2001

## SECTION

### LAND CORNER RECORDATION CERTIFICATE Filing Requirement of Act 74, Mich. P.A. 1970

Approved by Menominee County  
Land Survey Remonumentation  
Peer Group Under Act 345 of  
P.A. of 1990 On 7/13, 2000  
MLL Davis RLS  
Chairman

*Book 6 Page 178*

For corners in  
MENOMINEE  
(County)

| Located In:                 | Corner Code # |
|-----------------------------|---------------|
| T <u>35</u> N R <u>26</u> W | J-9           |
| T ___ R ___                 | _____         |
| T ___ R ___                 | _____         |
| T ___ R ___                 | _____         |
| S ___ T ___ R ___           | _____         |
| S ___ T ___ R ___           | _____         |
| S ___ T ___ R ___           | _____         |
| S ___ T ___ R ___           | _____         |

RECEIVED FOR RECORD  
13 DEC 2000 10:16:09 A  
BARBARA MORRISON  
REGISTER OF DEEDS  
MENOMINEE, MI 49858

Register of Deeds Stamp & File Number

- Public Land Survey
- Property Controlling in Section
- Miscellaneous Property in Sec.
- Lot No. \_\_\_\_\_, Recorded Plat \_\_\_\_\_
- Private Claims \_\_\_\_\_

|    | A  | B | C  | D | E  | F | G  | H | I  | J | K  | L | M |
|----|----|---|----|---|----|---|----|---|----|---|----|---|---|
| 1  |    |   |    |   |    |   |    |   |    |   |    |   |   |
| 2  | 6  |   | 5  |   | 4  |   | 3  |   | 2  |   | 1  |   |   |
| 3  |    |   |    |   |    |   |    |   |    |   |    |   |   |
| 4  | 7  |   | 8  |   | 9  |   | 10 |   | 11 |   | 12 |   |   |
| 5  |    |   |    |   |    |   |    |   |    |   |    |   |   |
| 6  | 18 |   | 17 |   | 16 |   | 15 |   | 14 |   | 13 |   |   |
| 7  |    |   |    |   |    |   |    |   |    |   |    |   |   |
| 8  | 19 |   | 20 |   | 21 |   | 22 |   | 23 |   | 24 |   |   |
| 9  |    |   |    |   |    |   |    |   |    |   |    |   |   |
| 10 | 30 |   | 29 |   | 28 |   | 27 |   | 26 |   | 25 |   |   |
| 11 |    |   |    |   |    |   |    |   |    |   |    |   |   |
| 12 | 31 |   | 32 |   | 33 |   | 34 |   | 35 |   | 36 |   |   |
| 13 |    |   |    |   |    |   |    |   |    |   |    |   |   |

I, William Lenca, in a field survey on Sep., 1900 do hereby state that under requirements of P.A. 74, Michigan P.A. of 1970, the corner points mentioned in lines 1 and 2 above were in conformance with regulations and rules therefore as required in the current manual of survey instructions of the United States Department of the Interior, Bureau of Land Management or by a decree of a Court of Law and/or that the corner points mentioned in lines 3, 4 and 5 above were in conformance with the rules of the Michigan Board of Land Surveyors or by a Decree of a Court of Law, established, re-established, monumented, recovered, found as expressed below:


NOTE: Not more than 2 corners, all in the same town and range, may be recorded on this certificate.

A. Description of original monument and accessories and/or subsequent restoration:

- 1848: Original Survey by James H. Mullett - B.T.'s - Beech, 12" - N62°E - 16 lks.; Sugar, 12" - S75°W - 29 lks.; All original evidence for this corner has been destroyed by County Road improvements.
- 1975: L.C.R.C. No. 117, Book 1, by David B. Babbitt, RLS No. 21558 states "Set 1/2" pipe with plastic R.L.S. cap from Co. Road witnesses to road P.I. - centerline of road E-W-N could find no other evidence of the 1/4 corner location." TIES: Face of Power Pole, N42°E, 47.9'; T.P. & Guy Pole, S48°E, 46.2'.

B. Description of corner evidence found and/or method applied in restoring or reestablishing corner:

Found a 1/2 inch diameter iron pipe in place as described in L.C.R.C. No. 117. The corner monument is in line with county road centerlines running East - West and North, fits reasonably well with measurements to corners 1/2 mile West (2693.26 feet) and 1/2 mile East (2706.01 feet) and is accepted as the best available evidence of the position of the original corner.

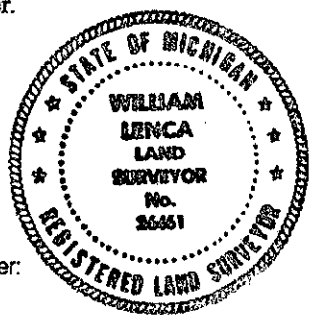

C. Description of monument for corner and accessories established to perpetuate locating the position of the corner:

- Set 5/8" x 24" Iron Rod/3-1/4" dia. Alum. cap stamped for corner location in Monument Box:
 

|   |       |            |                         |
|---|-------|------------|-------------------------|
| 5/8" x 24" Iron Rod/2" dia. Alum. cap marked "WITNESS MARKER" | N44°E | 49.16 feet | 1.0' E. of Power Pole   |
| 5/8" x 24" Iron Rod/2" dia. Alum. cap marked "WITNESS MARKER" | S48°E | 47.35 feet | 1.0' E. of Anchor Pole  |
| 5/8" x 24" Iron Rod/2" dia. Alum. cap marked "WITNESS MARKER" | N39°W | 46.59 feet | 1.0' E. of Rd Sign Post |
| Metal Survey Sign Post  | South | 29.75 feet |                         |
| Nothing Else Nearby   |       |            |                         |

NOTE: All bearings are magnetic bearings. All distances are measured with steel tape. Distances to trees are to nail in side of tree.

Signed by William Lenca  
Surveyor's Michigan License No. 26461

Date Nov. 16, 2000