

SURVEY &  
REMONUMENTATION

MAR 29 2000

SECTION

LAND CORNER RECORDATION CERTIFICATE  
Filing Requirement of Act 74, Mich. P.A. 1970

Approved by Menominee County  
Land Survey Remonumentation  
Peer Group Under Act 345 Of  
P.A. of 1990 On 10/11 1999  
Mc Davis ELS  
Chairman

For corners in MENOMINEE <small>(County)</small>	Located In:	Corner Code #
1. Public Land Survey	T <u>35</u> N R <u>27</u> W	C-6
	T___ R___	_____
	T___ R___	_____
	T___ R___	_____
2. Property Controlling in Section	S___ T___ R___	_____
	S___ T___ R___	_____
3. Miscellaneous Property in Sec.	S___ T___ R___	_____
	S___ T___ R___	_____

BK. 6 Pg. 95


RECEIVED FOR RECORD  
28 DEC 1999 3:56:09 PM  
BARBARA MORRISON  
REGISTER OF DEEDS  
MENOMINEE, MI 49858

Register of Deeds Stamp & File Number

4. Lot No. \_\_\_\_\_, Recorded Plat \_\_\_\_\_  
5. Private Claims \_\_\_\_\_

William Lenca in a field survey on Dec., 1999 do hereby state that under requirements of P.A. 74, Michigan P.A. of 1970, the corner points mentioned in lines 1 and 2 above were in conformance with regulations and rules therefore as required in the current manual of survey instructions of the United States Department of the Interior, Bureau of Land Management or by a decree of a Court of Law and /or that the corner points mentioned in lines 3, 4 and 5 above were in conformance with the rules of the Michigan Board of Land Surveyors or by a Decree of a Court of Law, established, re-established, monumented, recovered, found as expressed below.

NOTE: Not more than 2 corners, all in the same town and range, may be recorded on this certificate.

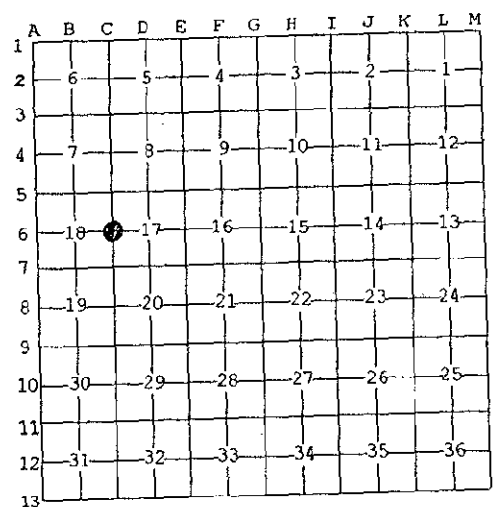

A. Description of original monument and accessories and/or subsequent restoration:

1848: Original Survey by James H. Mullett - B.T.'s - Hemlock, 6" - N23°W - 04 lks; Hemlock, 4" - S50°W - 12 lks. All original evidence for this corner has been destroyed by county road improvements.

B. Description of corner evidence found and/or method applied in restoring or reestablishing corner:

We set this corner in the centerline of a North - South Gravel surface County Road and in line with an ancient fence line running West. This position fits well with existing lines of occupation and with measurements to corners 1/2 mile North (2633.87') and 1/2 mile South (2612.78'), and is accepted as the best available evidence of the position of the original corner.

C. Description of monument for corner and accessories established to perpetuate locating the position of the corner:

Set 2" dia. Aluminum Pipe 30" long/3-1/4" dia. Alum cap stamped for corner location:

Lower Hinge Pin of S. Gate Post	S80°E	66.23 feet	Scr. NBT
8" dia. White Ash	S27°W	33.05 feet	Scr. NBT
9" dia. White Pine	West	52.94 feet	Scr. NBT
5" dia. Maple	N12°W	65.71 feet	Scr. NBT
Metal Survey Sign Post	West	19.7 feet	



NOTE: All bearings are magnetic bearings. All distances are measured with steel tapc. Distances to trees are to nail in side of tree.

Signed by William Lenca 26461  
Surveyor's Michigan License No. \_\_\_\_\_

Date Dec. 17, 1999