

SURVEY & REMONUMENTATION

OCT 27 1999

SECTION

LAND CORNER RECORDATION CERTIFICATE
Filing Requirement of Act 74, Mich. P.A. 1970

Approved by Menominee County
Land Survey Remonumentation
Peer Group Under Act 345 Of
P.A. Of 1990 On 10/11 1999
Mr. David RLS
Chairman

For corners in

MENOMINEE
(County)


Located In: Corner Code #

- | | | |
|------------------------------------|-----------------------------|------------|
| 1. Public Land Survey | T <u>35</u> N R <u>27</u> W | <u>D-5</u> |
| | T ___ R ___ | _____ |
| | T ___ R ___ | _____ |
| | T ___ R ___ | _____ |
| 2. Property Controlling in Section | S ___ T ___ R ___ | _____ |
| | S ___ T ___ R ___ | _____ |
| 3. Miscellaneous Property in Sec. | S ___ T ___ R ___ | _____ |
| | S ___ T ___ R ___ | _____ |

RECEIVED FOR RECORD
99 OCT 15 PM 1:41
PAGE # 24 BK 6
BARBARA MORRISON
REGISTER OF DEEDS
MENOMINEE, MI 49856

Register of Deeds Stamp & File Number

4. Lot No. _____, Recorded Plat _____
5. Private Claims _____

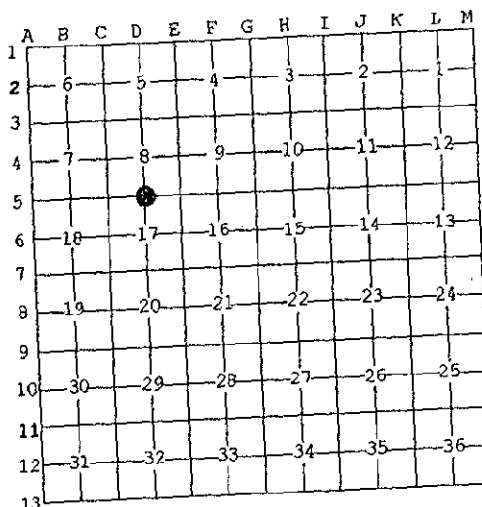

I, William Lenca, in a field survey on Sep., 1999 do hereby state that under requirements of P.A. 74, Michigan P.A. of 1970, the corner points mentioned in lines 1 and 2 above were in conformance with regulations and rules therefore as required in the current manual of survey instructions of the United States Department of the Interior, Bureau of Land Management or by a decree of a Court of Law and /or that the corner points mentioned in lines 3, 4 and 5 above were in conformance with the rules of the Michigan Board of Land Surveyors or by a Decree of a Court of Law; established, re-established, monumented, recovered, found as expressed below.

NOTE: Not more than 2 corners, all in the same town and range, may be recorded on this certificate.

A. Description of original monument and accessories and/or subsequent restoration:

- 1848: Original Survey by James H. Mullett - B.T.'s - Hemlock, 12" - N08°E - 07 lks; Birch, 6" - S28°E - 11 lks. All original evidence for this corner has been destroyed by county road improvements.
1963: Plat of Survey by Robert Olsen (RLS No. 10700) shows this corner as being in the centerline of and East - West County Road and states "used ex. old fence" (running North).

B. Description of corner evidence found and/or method applied in restoring or reestablishing corner:


We recovered a 1 inch diameter iron rod 8 inches below the road surface and in the centerline of an East - West County Road and in line with ancient fences running North and South from this location. This position fits well with measurements to corners 1/2 mile East (2671.99 feet) and 1/2 mile West (2663.23 feet), has been used by local surveyors for 36 years, and is accepted as the best available evidence of the position of the original corner. (NOTE: The existing iron rod is embedded in rock, and we were unable to remove it.)

C. Description of monument for corner and accessories established to perpetuate locating the position of the corner:

Set Monument Box over existing 1 inch diameter iron rod:

- | | | | |
|---|-------|------------|--------------------|
| 8" dia. Maple | N70°E | 70.33 feet | Scr. NBT |
| N. Tree of Twin 8" dia. Cedars | S35°E | 80.34 feet | Scr. NBT |
| 16" dia. Cedar | S52°W | 82.05 feet | Scr. NBT |
| 5/8" x 24" Iron Rod/2" dia. Alum. cap marked "WITNESS MARKER" | North | 31.78 feet | @ Survey Sign Post |
| Metal Survey Sign Post | North | 32.9 feet | |

NOTE: All bearings are magnetic bearings. All distances are measured with steel tape. Distances to trees are to nail in side of tree.

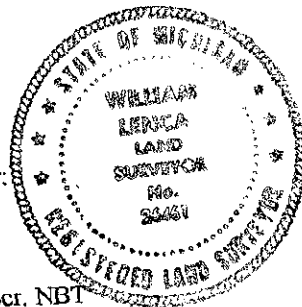

Signed by William Lenca
Surveyor's Michigan License No. 2441

Date Sep. 27, 1999