

APR 06 1998

Approved by Menominee County  
Land Survey Remonumentation  
Peer Group Under Act 345 Of

P.A. Of 1998 On 12/30 1998

Mc Davis RL  
Chairman

SECTION LAND CORNER RECORDATION CERTIFICATE  
Filing Requirement of Act 74, Mich. P.A. 1970

For corners in

MENOMINEE

(County)

Located In:

Corner Code #

- |                                    |                             |       |
|------------------------------------|-----------------------------|-------|
| 1. Public Land Survey              | T <u>35</u> N R <u>27</u> W | D-11  |
|                                    | T ___ R ___                 | _____ |
|                                    | T ___ R ___                 | _____ |
|                                    | T ___ R ___                 | _____ |
| 2. Property Controlling in Section | S ___ T ___ R ___           | _____ |
|                                    | S ___ T ___ R ___           | _____ |
| 3. Miscellaneous Property in Sec.  | S ___ T ___ R ___           | _____ |
|                                    | S ___ T ___ R ___           | _____ |

PAGE # 719  
BARBARA MORRISON  
REGISTER OF DEEDS  
MENOMINEE, MI 49858

RECEIVED FOR RECORD  
99 JAN -6 AM 8:55

Register of Deeds Stamp & File Number

4. Lot No. \_\_\_\_\_, Recorded Plat \_\_\_\_\_  
5. Private Claims \_\_\_\_\_

I, William Lenca, in a field survey on May, 1998 do hereby state that under requirements of P.A. 74, Michigan P.A. of 1970, the corner points mentioned in lines 1 and 2 above were in conformance with regulations and rules therefore as required in the current manual of survey instructions of the United States Department of the Interior, Bureau of Land Management or by a decree of a Court of Law and /or that the corner points mentioned in lines 3, 4 and 5 above were in conformance with the rules of the Michigan Board of Land Surveyors or by a Decree of a Court of Law; established, re-established, monumented, recovered, found as expressed below:

NOTE: Not more than 2 corners, all in the same town and range, may be recorded on this certificate.

A	B	C	D	E	F	G	H	I	J	K	L	M
1												
2	6		5		4		3		2		1	
3												
4	7		6		9		10		11		12	
5												
6	18		17		16		15		14		13	
7												
8	19		20		21		22		23		24	
9												
10	30		29		28		27		26		25	
11												
12	31		32		33		34		35		36	
13												

A. Description of original monument and accessories and/or subsequent restoration:

- 1848: Original Survey by James H. Mullett - B.T.'s - Beech, 10" - S84°E - 32 lks.; Beech, 10" - N74°W - 32 lks. All original evidence for this corner has been destroyed by logging activities.  
1984: Certified Survey Number 380 by George B. Wilson shows an existing Wisconsin Public Service Corner at this location.  
1989: Certified Survey Number 641 by William Lenca shows a tie to this corner.


B. Description of corner evidence found and/or method applied in restoring or reestablishing corner:

We recovered a 2 inch diameter iron pipe with a 2-1/4 inch diameter brass cap stamped for corner location with an old squared wood post next to it. The corner falls in an old North - South Fence line and is shown in Certified Survey No. 380 as "W.P.S. COR." The corner position falls 21.16 feet West of fitting midpoint between Section Corners. The 1/2 mile East measures 2765.55 feet and the 1/2 mile West measures 2723.23 feet. The corner monument has been continuously used by local surveyors for many years, fits with existing lines of occupation, and is accepted as the best available evidence of the position of the original corner.

C. Description of monument for corner and accessories established to perpetuate locating the position of the corner:

Accepted existing 2" dia. Iron Pipe/2-1/4" Brass cap stamped for corner location:

5/8" x 24" Iron Rod/2" dia. Alum. cap marked "WITNESS MARKER"	North	43.02 feet	1' W. of Fc. Post
5/8" x 24" Iron Rod/2" dia. Alum. cap marked "WITNESS MARKER"	S71°E	71.21 feet	1' W. of Fc. Post
5/8" x 24" Iron Rod/2" dia. Alum. cap marked "WITNESS MARKER"	S25°E	18.95 feet	1' N. of Fc. Post
Metal Survey Sign Post	West	1.0 feet	

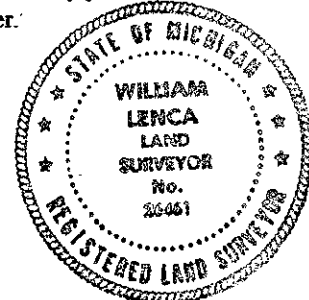

NOTE: All bearings are magnetic bearings. All distances are measured with steel tape. Distances to trees are to nail in side of tree.

Signed by William Lenca

Date Dec. 29, 1998

Surveyor's Michigan License No. 26461