

APR 06 1998

SECTION

Approved by Menominee County  
Land Survey Remonumentation  
Peer Group Under Act 345 Of  
P.A. of 1990 On 12/3, 199 B  
McL Davis RLS  
Chairman

LAND CORNER RECORDATION CERTIFICATE  
Filing Requirement of Act 74, Mich. P.A. 1970

For corners in  
MENOMINEE  
(County)


Located In:	Corner Code #
T 35NR 27W	E-07
T R	
T R	
T R	
S T R	
S T R	
S T R	
S T R	

- Public Land Survey
- Property Controlling in Section
- Miscellaneous Property in Sec.

RECEIVED FOR RECORD  
99 JAN -6 AM 8:55  
PAGE # 721 23/25  
BARBARA MORRISON  
REGISTER OF DEEDS  
MENOMINEE MI 49968

Register of Deeds Stamp & File Number

4. Lot No. \_\_\_\_\_, Recorded Plat \_\_\_\_\_  
5. Private Claims \_\_\_\_\_

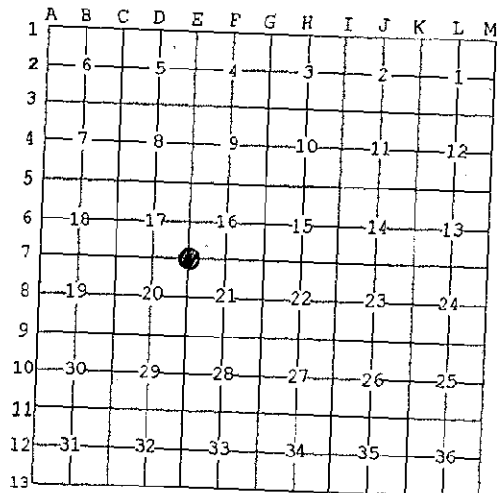

I, William Lenca, in a field survey on Mar. 11, 19 98 do hereby state that under requirements of P.A. 74, Michigan P.A. of 1970, the corner points mentioned in lines 1 and 2 above were in conformance with regulations and rules therefore as required in the current manual of survey instructions of the United States Department of the Interior, Bureau of Land Management or by a decree of a Court of Law and/or that the corner points mentioned in lines 3, 4 and 5 above were in conformance with the rules of the Michigan Board of Land Surveyors or by a Decree of a Court of Law; established, re-established, monumented, recovered, found as expressed below:

NOTE: Not more than 2 corners, all in the same town and range, may be recorded on this certificate.

A. Description of original monument and accessories and/or subsequent restoration:

1848: Original Survey by James H. Mullett - B.T.'s - Cedar, 8" - S17°E - 25 lks.; Cedar, 10" - N54°W - 31 lks. All original evidence for this corner has been destroyed by logging activities.


B. Description of corner evidence found and/or method applied in restoring or reestablishing corner:

We found an ancient corner post at the intersection of fences running North, East, and West. Nick Thoney, a long time resident of the area, showed us this position and stated that the old fence corner has been used as the corner position for many years. This position matches well with corners 1 mile West and 1 mile South. There is a GLO Stream call 212.8 feet West. We compassed West and intersected the stream at 73 feet, 170 feet and 220 feet. The bends in the stream are very close to the line, and a slight variance South would intersect the stream very close to the GLO call. We accepted the ancient fence corner as the best available evidence of the position of the original corner.

C. Description of monument for corner and accessories established to perpetuate locating the position of the corner:

Set 3/4" x 4' Alum. Rod/3-1/4" dia. Alum. cap stamped for corner location:

6" dia. Cedar	N31°E	23.14 feet	Scr. NBT
10" dia. Cedar	S32°E	34.30 feet	Scr. NBT
7" dia. Cedar	S19°W	26.43 feet	Scr. NBT
5" dia. White Ash	N76°W	9.10 feet	Scr. NBT
Metal Survey Sign Post	East	1.05 feet	

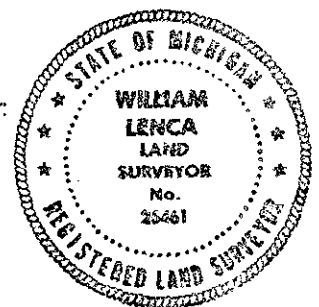

NOTE: All bearings are magnetic bearings. All distances are measured with steel tape. Distances to trees are to nail in side of tree.

Signed by William Lenca Date Dec. 22, 1998  
Surveyor's Michigan License No. 26461