

Approved by Macomb County
Land Survey Reauthorization
Peer Group Under Act 245 Of

P.A. Of 1990 On 10/26 19995

McC. Smith RLS
Chairman

LAND CORNER RECORDATION CERTIFICATE
Filing Requirement of Act 74, Mich. P.A. 1970

For corners in

MENOMINEE
(County)

Located in: Corner Code 11

1. Public Land Survey	T	35N	R	27W	G-3
	T		R		
	T		R		
	T		R		
2. Property Controlling in Section	S		T	R	
	S		T	R	
3. Miscellaneous Property in Sec.	S		T	R	
	S		T	R	


RECORDED FOR RECORD
95 NOV - 8 AM 11:30
PAGE # 226
REGISTERED LAND SURVEYOR
WILLIAM LENCA
REGISTERED LAND SURVEYOR
NO. 36461

Register of Deeds Stamp & File Number

- 4. Lot No. _____ Recorded Plat _____
- 5. Private Claims _____

I, William Lenca, in a field survey on Feb 23, 1995
do hereby certify that under requirements of P.A. 74, Michigan P.A. of 1970, the corner points mentioned in lines 1 and 2 above were in conformance with regulations and rules therefore as required in the current manual of survey instructions of the United States Department of the Interior, Bureau of Land Management or by a decree of a Court of Law and/or that the corner points mentioned in lines 3, 4 and 5 above were in conformance with the rules of the Michigan Board of Land Surveyors or by a Decree of a Court of Law: established, re-established, monumented, re-monumented, recovered, found as expressed below.

NOTE: Not more than 4 corners, all in the same town and range, may be recorded on this certificate.

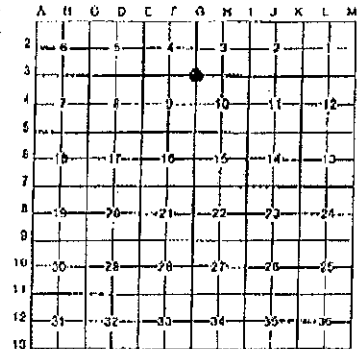

A. Description of original monument and accessories and/or subsequent restoration:

- 1848: Original Survey by James H. Mullett - B.T.'s - Tamarack, 14" - S71°W - 14 lks; Tamarack, 12" - N44°W - 19 lks. All original evidence has been destroyed by logging activities.
- 1994: LCRC No. 206 recorded in Book 4 of Corner Records by Edward Kazianka, RLS No. 14765 states that a 1" x 6" Iron Pipe/4" dia. Alum. cap was set - NEW B.T.'s - Cedar, 7" - N51°E - 12.84'; Cedar, 6" - S55°E - 19.03'; Cedar, 6" - S10°W - 12.85'; Tamarack, 6" - N14°W - 4.78' - SEE REVERSE SIDE FOR COPY OF LCRC 206, BOOK 4.

B. Description of corner evidence found and/or method applied in restoring or reestablishing corner:


We recovered a 1 inch diameter iron pipe 6 feet long with a 4 inch diameter aluminum cap in a location indicated by information in LCRC No. 206, Book 4. This corner fits well with existing long standing occupation and is accepted as the best available evidence of the position of the original corner.

C. Description of monument for corner and accessories established to perpetuate locating the position of the corner:

Accepted existing 1" x 6" Iron pipe/4" dia. Alum. cap stamped for corner:

7" dia. Cedar	N51°E	12.84 feet	Ser NBT
7" dia. Cedar	S55°E	19.03 feet	Ser NBT
7" dia. Cedar	S10°W	12.85 feet	Ser NBT
6" dia. Tamarack	N14°W	4.78 feet	Ser. NBT

NOTE: All bearings are magnetic bearings. All distances are measured with a steel tape. Distances to trees are to nail in side of tree.

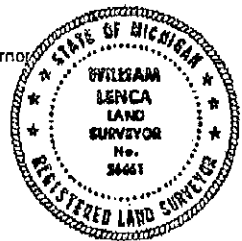

Signed by William Lenca Date July 31, 1995
Surveyor's Michigan License No. 26461

LAND CORNER RECORDATION CERTIFICATE
Filing Requirement of Act 74, Mich. P.A. 1970

For corners in

Table with columns: Monolinee (County), Located in, Corner Code -//. Includes entries for Public Land Survey, Property Controlling, and Miscellaneous.

RECEIVED FOR RECORD
95 JAN 19 AM 10:56
BARBARA NORRISON
REGISTERED CLERK

Register of Deeds Stamp & File Number

4. Lot No. Recorded Plat
6. Private Claims

Grid table with columns A-M and rows 2-13, likely for recording corner locations.

I, Edward Kazianka, in a field survey on July 28, 1991, do hereby certify that under requirements of P.A. 74, Michigan P.A. of 1970, the corner points mentioned in lines 1 and 2 above were in conformance with regulations and rules therefore as required in the current manual of survey instructions of the United States Department of the Interior, Bureau of Land Management or by a decree of a Court of Law and/or that the corner points mentioned in lines 3, 4 and 5 above were in conformance with the rules of the Michigan Board of Land Surveyors or by a Decree of a Court of Law; established, re-established, monumented, re-monumented, recovered, found as expressed below:

NOTE: Not more than 4 corners, all in the same town and range, may be recorded on this certificate.

A. Description of original monument and accessories and/or subsequent restoration:
G-3 Wood post as corner of Sections 3, 4, 9 & 10.
Tamarack 12 N44W 19 lks. Tamarack 14 S71W 14 lks.

B. Description of corner evidence found and/or method applied in restoring or reestablishing corner:
G-3 No evidence of original corner or accessories found. Quarter corners 1/2 mile north and south are in with a distance of 5224.4 feet between them. Proportionately then, the section corner should be set 2612.2 feet from either Quarter corner. An iron pipe marks the Quarter corner 1/2 mile east and a PK nail in the centerline of the county road marks the Quarter corner 1/2 mile to the west with a distance of 5478.5 feet between them. 1392.2 feet east of the centerline of the county road is a north-south fence-line that Mr. Linderoth, the adjacent landowner, stated has been accepted as the forty line for at least the last fifty years. By setting the section corner 2784.4 feet east of the road centerline, an ancient north-south fence-line is only one foot off the mid-point between it and the Quarter corner 1/2 mile to the east. Thus have set the section corner 2612.2 feet south of the Quarter corner between Sections 3 and 4, and 2784.4 feet east of the Quarter corner between Section 4 and 9.

C. Description of monument for corner and accessories established to perpetuate locating the position of the corner:
G-3 Four inch Alum cap on a six foot 1" iron pipe.
Cedar 7 N51E 12.84 feet. Cedar 6 S55E 19.03 feet.
Cedar 6 S10W 12.85 feet. Tamarack 6 N44W 4.78 feet.

Signed by Edward Kazianka Date January 17, 1995
Surveyor's Michigan License No. 11765



206 (page 2) of #226

FORM APPROVED BY MICHIGAN STATE BOARD OF LAND SURVEYORS, JAN 26 1997