

MAR 29 2000

SECTION

LAND CORNER RECORDATION CERTIFICATE  
Filing Requirement of Act 74, Mich. P.A. 1970

Approved by Menominee County  
Land Survey Remonumentation  
Peer Group Under Act 345 Of  
P.A. Of 1990 On 10/11 1999  
McC Davis RLS  
Chairman

For corners in  
MENOMINEE

Located In: Corner Code #

- |                                       |                             |       |
|---------------------------------------|-----------------------------|-------|
| 1. Public Land Survey                 | T <u>35</u> N R <u>27</u> W | G-07  |
|                                       | T ___ R ___                 | _____ |
|                                       | T ___ R ___                 | _____ |
|                                       | T ___ R ___                 | _____ |
| 2. Property Controlling<br>in Section | S ___ T ___ R ___           | _____ |
|                                       | S ___ T ___ R ___           | _____ |
| 3. Miscellaneous<br>Property in Sec.  | S ___ T ___ R ___           | _____ |
|                                       | S ___ T ___ R ___           | _____ |

Bk. 6 Pg. 104

RECEIVED FOR RECORD  
28 DEC 1999 3:56:09 PM  
BARBARA MORRISON  
REGISTER OF DEEDS  
MENOMINEE, MI 49858

Register of Deeds Stamp & File Number

4. Lot No. \_\_\_\_\_, Recorded Plat \_\_\_\_\_  
5. Private Claims \_\_\_\_\_

I, William Lenca, in a field survey on Nov., 1999 do hereby state that under requirements of P.A. 74, Michigan P.A. of 1970, the corner points mentioned in lines 1 and 2 above were in conformance with regulations and rules therefore as required in the current manual of survey instructions of the United States Department of the Interior, Bureau of Land Management or by a decree of a Court of Law and /or that the corner points mentioned in lines 3, 4 and 5 above were in conformance with the rules of the Michigan Board of Land Surveyors or by a Decree of a Court of Law; established, re-established, monumented, recovered, found as expressed below:

	A	B	C	D	E	F	G	H	I	J	K	L	M
1													
2	6		5		4		3		2		1		
3													
4	7		8		9		10		11		12		
5													
6	18		17		16		15		14		13		
7							●						
8	19		20		21		22		23		24		
9													
10	30		29		28		27		26		25		
11													
12	31		32		33		34		35		36		
13													

NOTE: Not more than 2 corners, all in the same town and range, may be recorded on this certificate.

A. Description of original monument and accessories and/or subsequent restoration:

1848: Sectional Subdivision by James H. Mullett - B.T.'s - Cedar, 6" - S51°E - 06 lks.; Cedar, 5" - N28°W - 02 lks. All original evidence for this corner has been destroyed county road improvements.


B. Description of corner evidence found and/or method applied in restoring or reestablishing corner:

We recovered a 5/8 inch diameter iron rod 24 inches long in the centerline of county road running East - West - North and in line with an old fence running South. The measurements to corners 1/2 mile West (2673.45'), 1/2 mile North (2616.17') and 1/2 mile East (2683.37') fit reasonably well. The measurement to the corner 1/2 mile South is almost 100 feet long (2738.96'). Since there is no great shortage in measurement between corners from this point South to the Township Line, and since other measurements along this line are almost 100 feet long, we accepted the position of the existing iron as the best available evidence of the position of the original corner.

C. Description of monument for corner and accessories established to perpetuate locating the position of the corner:

Set 2" dia. Aluminum Pipe 30" long/3-1/4" dia. Alum cap stamped for corner location:

5" dia. Cedar	N40°E	73.27 feet	Scr. NBT
9" dia. Cedar	S61°E	83.99 feet	Scr. NBT
14" dia. Cedar	S08°E	38.32 feet	Scr. NBT
5" dia. Cedar	S52°W	66.17 feet	Scr. NBT
Metal Survey Sign Post	South	25.9 feet	

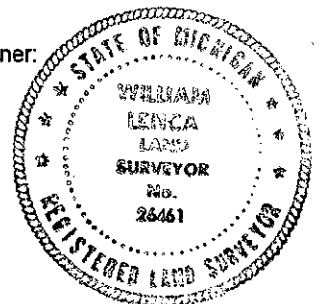

NOTE: All bearings are magnetic bearings. All distances are measured with steel tape. Distances to trees are to nail in side of tree.

Signed by William Lenca  
Surveyor's Michigan License No. 26461

Date Dec. 17, 1999