

MAR 29 2000

SECTION

LAND CORNER RECORDATION CERTIFICATE  
Filing Requirement of Act 74, Mich. P.A. 1970

Approved by Menominee County  
Land Survey Remonumentation  
Peer Group Under Act 345 Of  
P.A. Of 1990 On 10/11 1999  
McC Davis RLS  
Chairman

For corners in  
MENOMINEE  
(County)

Located in:	Corner Code #
T <u>35N</u> R <u>27W</u>	G-8
T ___ R ___	_____
T ___ R ___	_____
T ___ R ___	_____
S ___ T ___ R ___	_____
S ___ T ___ R ___	_____
S ___ T ___ R ___	_____
S ___ T ___ R ___	_____

BK. 6 Pg. 105

RECEIVED FOR RECORD  
28 DEC 1999 3:56:09 PM  
BARBARA MORRISON  
REGISTER OF DEEDS  
MENOMINEE, MI 49858

Register of Deeds Stamp & File Number

4. Lot No. \_\_\_\_\_, Recorded Plat \_\_\_\_\_  
5. Private Claims \_\_\_\_\_

I, William Lenca, in a field survey on Nov. . . . , 1999 do hereby state that under requirements of P.A. 74, Michigan P.A. of 1970, the corner points mentioned in lines 1 and 2 above were in conformance with regulations and rules therefore as required in the current manual of survey instructions of the United States Department of the Interior, Bureau of Land Management or by a decree of a Court of Law and/or that the corner points mentioned in lines 3, 4 and 5 above were in conformance with the rules of the Michigan Board of Land Surveyors or by a Decree of a Court of Law; established, re-established, monumented, recovered, found as expressed below:

	A	B	C	D	E	F	G	H	I	J	K	L	M
1													
2	6		5		4		3		2		1		
3													
4	7		8		9		10		11		12		
5													
6	10		17		16		15		14		13		
7													
8	19		20		21		22		23		24		
9													
10	30		29		28		27		26		25		
11													
12	31		32		33		34		35		36		
13													

NOTE: Not more than 2 corners, all in the same town and range, may be recorded on this certificate.

A. Description of original monument and accessories and/or subsequent restoration:

- 1848: Original Survey by James H. Mullett - B.T.'s - Beech, 9" - N21°W - 19 lks.; Hemlock, 8" - N57°E - 15 lks. All original evidence for this corner has been destroyed county road improvements.
- 1990: L.C.R.C. No. 895 (Bk 3) by William Lenca, RLS No. 26461 - Set 5/8" x 24" Iron in center of E-W Co. Rd. and in line with ancient wire & rock fence to the North.


B. Description of corner evidence found and/or method applied in restoring or reestablishing corner:

We recovered a 5/8 inch diameter iron rod in the center of an East - West County Road matching with the ties shown in L.C.R.C. No. 895, Book 3. This corner position has been used by local surveyors for several years, fits well with long standing lines of occupation, and is accepted as the best available evidence of the position of the original corner.

C. Description of monument for corner and accessories established to perpetuate locating the position of the corner:

Set 5/8" x 24" Iron Rod/3-1/4" dia. Alum. cap stamped for corner location:

9" dia. Maple (Ex. B.T.)	N01°W	43.03 feet	Cross cut in upper & lower blaze
9" dia. Elm (Ex. B.T.)	N64°E	43.72 feet	Cross cut in upper & lower blaze
9" dia. White Ash (Ex. B.T.)	S33°E	27.78 feet	Cross cut in upper & lower blaze
14" dia. White Ash (Ex. B.T.)	S45°W	33.40 feet	Cross cut in upper & lower blaze
Metal Survey Sign Post	North	25.3 feet	

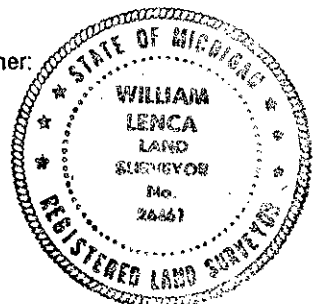

NOTE: All bearings are magnetic bearings. All distances are measured with steel tape. Distances to trees are to nail in side of tree.

Signed by William Lenca  
Surveyor's Michigan License No. 26461

Date Dec. 17, 1999