

LAND CORNER RECORDATION CERTIFICATE
 Filing Requirement of Act 74, Mich. P.A. 1970


For corners in

| MENOMINEE (County) | Located In: | Corner Code -# |
|------------------------------------|-------------------|----------------|
| | 35N - 27W | H-3 |
| Public Land Survey | T ___ R ___ | _____ |
| | T ___ R ___ | _____ |
| | T ___ R ___ | _____ |
| | T ___ R ___ | _____ |
| Property Controlling in Section | S ___ T ___ R ___ | _____ |
| | S ___ T ___ R ___ | _____ |
| Miscellaneous Property in Sec. | S ___ T ___ R ___ | _____ |

REGISTER FOR RECORD
 95 NOV - 8 AM 11:30
 PAGE # 230 BK 4
 BARBARA JOHNSON
 REGISTERED CLERK
 REGISTERED 11/11/93
 Register of Deeds Stamp & File Number

Lot No. _____, Recorded Plat _____
 Private Claims _____

William Lenca, in a field survey on Feb 17, 1995,
 hereby certify that under requirements of P.A. 74, Michigan P.A. of 1970, the corner points mentioned
 in lines 1 and 2 above were in conformance with regulations and rules therefore as required in the
 current manual of survey instructions of the United States Department of the Interior, Bureau of Land
 Management or by a decree of a Court of Law and/or that the corner points mentioned in lines 3, 4 and 5
 above were in conformance with the rules of the Michigan Board of Land Surveyors or by a Decree of a
 Court of Law; established, re-established, monumented, re-monumented, recovered, found as
 expressed below:

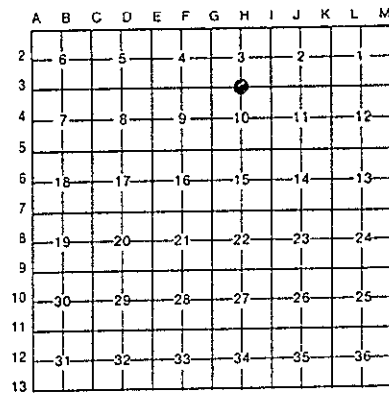

NOTE: Not more than 4 corners, all in the same town and range, may be recorded
 on this certificate.

Description of original monument and accessories and/or subsequent restoration:


1848: Original Survey by James H. Mullctt - B.T.'s - Cedar, 6" - S11°W - 05 lks; Cedar, 6" - N27°W - 10 lks. No original
 evidence for this corner was recovered.

Description of corner evidence found and/or method applied in restoring or reestablishing corner:

In a February, 1995 survey of Section 10, T35N-R27W, we recovered the Northwest and the Northeast Section Corners, and found
 that the distance between them was 5379.44 feet. We set the quarter corner (H-3) midway and on line between the section corners.
 The corner position thus established fits well with existing lines of occupation and is accepted as a careful and faithful
 reestablishment of the position of the original corner.

Description of monument for corner and accessories established to perpetuate locating the position of the corner:

- Set 5/8" x 24" Iron Rod/3-1/4" dia. Alum. cap stamped for corner location:
- 8" dia. Cedar N55°E 16.28 feet Scr NBT
 - 6" dia. Cedar S41°E 21.13 feet Scr NBT
 - 7" dia. Cedar S46°W 15.00 feet Scr NBT
 - 10" dia. Cedar N61°W 24.11 feet Scr NBT

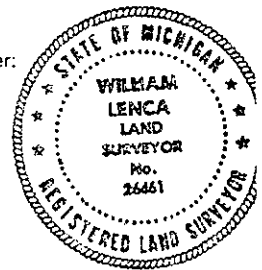

NOTE: All bearings are magnetic bearings. All distances are measured with a steel tape. Distances to trees are to nail in side of
 tree.

Signed by William Lenca Date July 31, 1995
 Surveyor's Michigan License No. 26461

SURVEY & RECORDATION