Approved by Menominee County
Land Survey Remonumentation
Peer Group Under Act 345 Of
P.A. Of 1990 On 10/26, 199 95
Mr Davis RLS
Chairman

LAND CORNER RECORDATION CERTIFICATE

Filing Requirement of Act 74, Mich. P.A. 1970

RECEIVED FOR RECORD
95 NOV -8 AM 11: 31
PAGE # 235-844
DATE BOOK OF THE REGISTER OF DEEDS
MENOMINEE COUNTY, MICHIGAN

Register of Deeds Stamp & File Number

For corners in MENOMINEE (County)

Located in: 35N T ____ R ____ 27W

Corner Code #: I-4

1. Public Land Survey T ____ R ____
2. Property Controlling in Section S ____ T ____ R ____
3. Miscellaneous Property in Sec. S ____ T ____ R ____
4. Lot No. _____, Recorded Plat _____
5. Private Claims _____

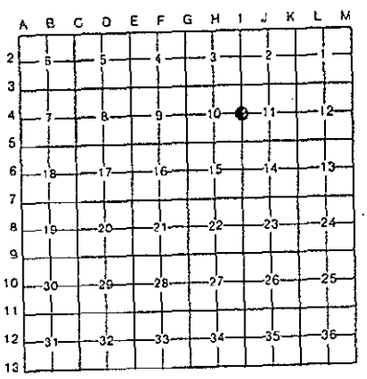

William Lenca, in a field survey on May 08, 19 95, do hereby certify that under requirements of P.A. 74, Michigan P.A. of 1970, the corner points mentioned in lines 1 and 2 above were in conformance with regulations and rules therefore as required in the current manual of survey instructions of the United States Department of the Interior, Bureau of Land Management or by a decree of a Court of Law and/or that the corner points mentioned in lines 3, 4 and 5 above were in conformance with the rules of the Michigan Board of Land Surveyors or by a Decree of a Court of Law; established, re-established, monumented, re-monumented, recovered, found as expressed below:

NOTE: Not more than 4 corners, all in the same town and range, may be recorded on this certificate.

6. Description of original monument and accessories and/or subsequent restoration:

1848: Original Survey by James H. Mullett - B.T.'s - Cedar, 6" - S12°E - 17 lks; Cedar, 6" - N89°W - 05 lks. All original evidence for this corner has been destroyed by county road improvements.

1979: Certified Survey No. 170 recorded by George E. Wilson, RLS No. 17607, indicates in the legend that a 1/2" diameter iron pin was set. A bearing and distance of N01°21'33"W, 2689.28 feet is shown between this corner and the Section Corner to the North.

7. Description of corner evidence found and/or method applied in restoring or reestablishing corner:

In a April 1995 survey of Section 3, T35N-R27W, we recovered a 1/2" diameter iron pin in the centerline of a North - South County road and in line with an old lane running West and a fence running East. We found that the distance between this corner and the Section corner to the north measured 2689.22 feet, which matches closely with Wilson's distance of 2689.28 feet as recorded in Certified Survey No. 170. This corner position has been used consistently for several years by local surveyors, and is accepted as the best available evidence of the position of the original corner.

STATE OF MICHIGAN
WILLIAM LENCA
LAND SURVEYOR
No. 26461
REGISTERED LAND SURVEYOR

8. Description of monument for corner and accessories established to perpetuate locating the position of the corner:

Set 2" dia. Aluminum Pipe/3-1/4" dia. Alum cap stamped for corner location:

7" dia. Cedar	S74°E	22.70 feet	Scr NBT
5" dia. Cedar	S30°E	51.93 feet	Scr NBT
7" dia. Elm	S48°W	38.75 feet	Scr NBT
9" dia. Tamarack	N37°W	78.99 feet	Scr. NBT

NOTE: All bearings are magnetic bearings. All distances are measured with a steel tape. Distances to trees are to nail in side of tree.

Signed by W. Lenca Date Sept. 6, 1995

Surveyor's Michigan License No. 26461

FORM APPROVED BY MICHIGAN STATE BOARD OF LAND SURVEYORS, JAN. 26, 1971
REVISED MAY 14, 1975
REVISED JAN., 1983

SURVEY 3