

APR 06 1999

SECTION

Approved by Menominee County  
Land Survey Remonumentation  
Peer Group Under Act 345 Of

P.A. Of 1990 On 10/29, 1998  
James S. Wenig P.S.  
Chairman

LAND CORNER RECORDATION CERTIFICATE  
Filing Requirement of Act 74, Mich. P.A. 1970

For corners in

<u>MENOMINEE</u> (County)	Located In:	Corner Code #
1. Public Land Survey	T <u>35</u> N R <u>27</u> W	<u>I-11</u>
	T ___ R ___	_____
	T ___ R ___	_____
	T ___ R ___	_____
2. Property Controlling in Section	S ___ T ___ R ___	_____
	S ___ T ___ R ___	_____
3. Miscellaneous Property in Sec.	S ___ T ___ R ___	_____
	S ___ T ___ R ___	_____

RECEIVED FOR RECORD  
93 DEC 14 PM 3:21  
PAGE # 672 BKS  
BARBARA MORRISON  
REGISTER OF DEEDS  
MENOMINEE COUNTY

Register of Deeds Stamp & File Number

4. Lot No. \_\_\_\_\_, Recorded Plat \_\_\_\_\_  
5. Private Claims \_\_\_\_\_

I, William Lenca, in a field survey on Mar. 26, 19 98 do hereby state that under requirements of P.A. 74, Michigan P.A. of 1970, the corner points mentioned in lines 1 and 2 above were in conformance with regulations and rules therefore as required in the current manual of survey instructions of the United States Department of the Interior, Bureau of Land Management or by a decree of a Court of Law and /or that the corner points mentioned in lines 3, 4 and 5 above were in conformance with the rules of the Michigan Board of Land Surveyors or by a Decree of a Court of Law; established, re-established, monumented, recovered, found as expressed below:

NOTE: Not more than 2 corners, all in the same town and range, may be recorded on this certificate.

A	B	C	D	E	F	G	H	I	J	K	L	M
1												
2	6		5		4		3		2		1	
3												
4	7		8		9		10		11		12	
5												
6	18		17		16		15		14		13	
7												
8	19		20		21		22		23		24	
9												
10	30		29		28		27		26		25	
11												
12	31		32		33		34		35		36	
13												

A. Description of original monument and accessories and/or subsequent restoration:

- 1848: Original Survey by James H. Mullett - B.T.'s - Hemlock, 14" - S38°W - 22 lks.; Birch, 18" - N18°E - 12 lks. All original evidence for this corner has been destroyed by county road improvements and farming activities.
- 1901: Survey by Albert Hass shows this corner was formerly set from Government B.T.'s - No B.T.'s are given, corner monument is not described.
- 1989: Certified Survey Number 669 by William Lenca shows this corner in relation to other corners in Section 35, T35N-R27W.


B. Description of corner evidence found and/or method applied in restoring or reestablishing corner:

We found a 1" x 18" Iron Pipe in the centerline of a County Road to the East and in line with an ancient fence running to the North. This corner matches closely with distances shown on the 1901 Survey by Albert Hass, has been used consistently by local surveyors for many years, fits well with existing lines of occupation, and is accepted as the best available evidence of the position of the original corner.

C. Description of monument for corner and accessories established to perpetuate locating the position of the corner:

Set 2" dia. Aluminum Pipe/3-1/4" dia. Alum. cap stamped for corner location:

5/8" x 24" Iron Rod/2" dia. Alum. cap marked "WITNESS MARKER"	North	14.13 feet	0.7' S. of Sign Post
5/8" x 24" Iron Rod/2" dia. Alum. cap marked "WITNESS MARKER"	South	54.72 feet	1.5' N. of 20" Elm
5/8" x 24" Iron Rod/2" dia. Alum. cap marked "WITNESS MARKER"	S58°E	69.17 feet	@ Fence Post
Metal Survey Sign Post	North	14.83 feet	

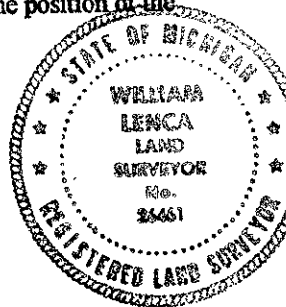

NOTE: All bearings are magnetic bearings. All distances are measured with steel tape. Distances to trees are to nail in side of tree.

Signed by William Lenca  
Surveyor's Michigan License No. 26461

Date Oct. 29, 1998

672