

MAR 29 2000

SECTION

LAND CORNER RECORDATION CERTIFICATE
Filing Requirement of Act 74, Mich. P.A. 1970

Approved by Menominee County
Land Survey Remonumentation
Peer Group Under Act 345 Of

P.A. Of 1999 On 10/11 1999
McL Davis RLS
Chairman

For corners in

MENOMINEE
(County)

Located In:

Corner Code #

- | | | |
|---------------------------------------|--------------------------|------------|
| 1. Public Land Survey | T <u>35NR</u> <u>27W</u> | <u>K-4</u> |
| | T ___ R ___ | _____ |
| | T ___ R ___ | _____ |
| | T ___ R ___ | _____ |
| 2. Property Controlling
in Section | S ___ T ___ R ___ | _____ |
| | S ___ T ___ R ___ | _____ |
| 3. Miscellaneous
Property in Sec. | S ___ T ___ R ___ | _____ |
| | S ___ T ___ R ___ | _____ |

BK. 6 Pg 111

RECEIVED FOR RECORD
28 DEC 1999 3:56:09 PM
BARBARA MORRISON
REGISTER OF DEEDS
MENOMINEE, MI 49858

Register of Deeds Stamp & File Number

4. Lot No. _____, Recorded Plat _____
5. Private Claims _____

I, William Lenca, in a field survey on Nov., 1999 do hereby state that under requirements of P.A. 74, Michigan P.A. of 1970, the corner points mentioned in lines 1 and 2 above were in conformance with regulations and rules therefore as required in the current manual of survey instructions of the United States Department of the Interior, Bureau of Land Management or by a decree of a Court of Law and /or that the corner points mentioned in lines 3, 4 and 5 above were in conformance with the rules of the Michigan Board of Land Surveyors or by a Decree of a Court of Law; established, re-established, monumented, recovered, found as expressed below:

NOTE: Not more than 2 corners, all in the same town and range, may be recorded on this certificate.

A	B	C	D	E	F	G	H	I	J	K	L	M
1												
2	6	5	4	3	2	1						
3												
4	7	8	9	10	11	12						
5												
6	18	17	16	15	14	13						
7												
8	19	20	21	22	23	24						
9												
10	30	29	28	27	26	25						
11												
12	31	32	33	34	35	36						
13												

A. Description of original monument and accessories and/or subsequent restoration:

- 1848: Original Survey by James H. Mullett - B.T.'s - Birch, 12" - N25°W - 6 lks.; Ironwood, 6" - S53°E - 28 lks. All original evidence for this corner has been destroyed by county road improvements.
1896: Subdivision of Section 11 by Justus Little shows this corner as it relates to other corners in Section 11 - TIES: River Ash, 10" - N75°W - 39.3'; River Ash, 5" - S29.5°W - 20.1' - destroyed by road improvements.
1980: L.C.R.C. No. 222 by Ed Kazianka, RLS No. 14765, states "Accepted center of county roads as being corner - set 5/8" x 12" re-rod - TIES: PP - S20°W - 79.90'; Stop Sign - S40°E - 39.80'; Stop Sign - N10°W - 105.50'.


B. Description of corner evidence found and/or method applied in restoring or reestablishing corner:

We recovered a 5/8" x 8 inch iron rod below the asphalt surface, and in the centerline of a 4 way county road intersection, and in a location matching the ties as described in L.C.R.C. No. 222 (sec part "A"). This corner position fits well with measurements to corners 1/2 mile North (2654.74 feet) and 1/2 mile South (2650.54 feet), has been used by local surveyors for several years, and is accepted as the best available evidence of the position of the original corner.

C. Description of monument for corner and accessories established to perpetuate locating the position of the corner:

Set 5/8" x 24" Iron Rod/3-1/4" dia. Alum. cap stamped for corner location in Monument Box:

- | | | | |
|--|---------|------------|----------------------|
| Nail in power pole | N 68° E | 86.26 feet | |
| 5/8" x 24" Iron Rod/2" Alum. cap marked WITNESS MARKER | S 48° E | 42.90 feet | 1 ft. E. of rd. sign |
| P.K. in power pole | S 16° W | 76.99 feet | |
| 5/8" x 24" Iron Rod/2" Alum. cap marked WITNESS MARKER | N 45° W | 43.96 feet | @ survey sign |
| Metal Survey Sign Post | N 45° W | 44.86 feet | |

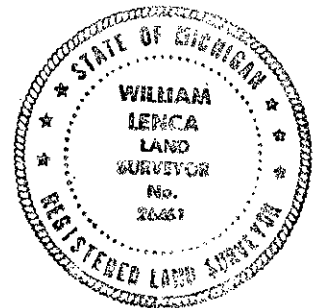

NOTE: All bearings are magnetic bearings. All distances are measured with steel tape.

Signed by William Lenca Date Nov. 23, 1999
Surveyor's Michigan License No. 26461