

MAR 29 2000

SECTION

LAND CORNER RECORDATION CERTIFICATE  
Filing Requirement of Act 74, Mich. P.A. 1970

Approved by Menominee County  
Land Survey Remuneration  
Pool Group Under Act 345 Of

P.A. Of 1999 On 10/11 1999  
McL Davis RLS  
Chairman

BK. 6 Pg. 113

For corners in  
MENOMINEE  
(County)

Located in:	Corner Code #
T <u>35</u> N R <u>27</u> W	K-6
T ___ R ___	_____
T ___ R ___	_____
T ___ R ___	_____
S ___ T ___ R ___	_____
S ___ T ___ R ___	_____
S ___ T ___ R ___	_____
S ___ T ___ R ___	_____

RECEIVED FOR RECORD  
28 DEC 1999 3:56:09 PM  
BARBARA MORRISON  
REGISTER OF DEEDS  
MENOMINEE, MI 49858

Register of Deeds Stamp & File Number

1. Public Land Survey

2. Property Controlling  
in Section

3. Miscellaneous  
Property in Sec.

4. Lot No. \_\_\_\_\_, Recorded Plat \_\_\_\_\_  
5. Private Claims \_\_\_\_\_

I, William Lenca, in a field survey on Dec., 1999 do hereby state that under requirements of P.A. 74, Michigan P.A. of 1970, the corner points mentioned in lines 1 and 2 above were in conformance with regulations and rules therefore as required in the current manual of survey instructions of the United States Department of the Interior, Bureau of Land Management or by a decree of a Court of Law and/or that the corner points mentioned in lines 3, 4 and 5 above were in conformance with the rules of the Michigan Board of Land Surveyors or by a Decree of a Court of Law, established, re-established, monumented, recovered, found as expressed below:

NOTE: Not more than 2 corners, all in the same town and range, may be recorded on this certificate.

	A	B	C	D	E	F	G	H	I	J	K	L	M
1													
2	6		5		4		3		2		1		
3													
4	7		8		9		10		11		12		
5													
6	18		17		16		15		14		13		
7													
8	19		20		21		22		23		24		
9													
10	30		29		28		27		26		25		
11													
12	31		32		33		34		35		36		
13													

A. Description of original monument and accessories and/or subsequent restoration:

- 1848: Sectional Subdivision by James H. Mullett - E.T.'s - Sugar, 16" - N43°W - 11 lks.; Birch, 4" - S55°E - 15 lks. All original evidence for this corner has been destroyed by farming activities.
- 1989: L.C.R.C. No. 872, Bk 3, by David Babbitt, RLS No. 21558 - Set DNR Mon. at very old fence corner with fences N-S-E & W. This monument is nearly MPOL between section corners based on c/l of road and record mea. north of a small stream for the NE section corner of Section 14. (No monument found or set for said NE section corner). TIES: S. Maple, 21" - N43°E - 67.85'; Twin S. Maple, 17" - N86°E - 88.7'; Cherry, 10" - S07°W - 33.5'; Fence Post - N77°W - 3.6'


B. Description of corner evidence found and/or method applied in restoring or reestablishing corner:

We found a standard DNR Monument at an ancient fence corner with fences running North - South - East and West, along with the 4 ties as described in LCRC No. 872, Book 3 (see part "A"). We accepted the existing corner monument as the best available evidence of the position of the original corner.

C. Description of monument for corner and accessories established to perpetuate locating the position of the corner:

Accepted Existing 1-1/2" dia. Iron Pipe/4" Alum. Cap (standard DNR Monument) stamped for corner location

21" dia. Maple	N43°E	68.69 feet	Scr. NBT
17" dia. Twin Maple	N86°E	88.70 feet	Scr. NBT
10" dia. Cherry	S07°W	33.52 feet	Scr. NBT
Metal Survey Sign Post	South	1.1 feet	

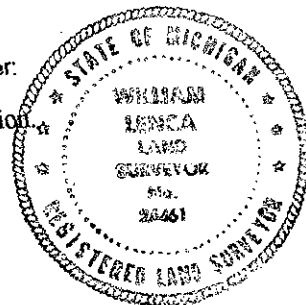

NOTE: All bearings are magnetic bearings. All distances are measured with steel tape. Distances to trees are to nail in side of tree.

Signed by William Lenca  
Surveyor's Michigan License No. 26461

Date Dec. 06, 1999