

MAR 29 2000

SECTION

LAND CORNER RECORDATION CERTIFICATE  
Filing Requirement of Act 74, Mich. P.A. 1970

Approved by Menominee County  
Land Survey Remanumentation  
Posr Group Under Act 345 Of  
P.A. Of 1990 On 10/11/99  
Mr. David R. G. S.  
Chairman  
BK. 6 Pg. 114

For corners in

MENOMINEE (County)	Located In:	Corner Code #
1. Public Land Survey	T <u>35N</u> R <u>27W</u>	<u>K-7</u>
	T <u>   </u> R <u>   </u>	<u>   </u>
	T <u>   </u> R <u>   </u>	<u>   </u>
	T <u>   </u> R <u>   </u>	<u>   </u>
2. Property Controlling in Section	S <u>   </u> T <u>   </u> R <u>   </u>	<u>   </u>
	S <u>   </u> T <u>   </u> R <u>   </u>	<u>   </u>
3. Miscellaneous Property in Sec.	S <u>   </u> T <u>   </u> R <u>   </u>	<u>   </u>
	S <u>   </u> T <u>   </u> R <u>   </u>	<u>   </u>

RECEIVED FOR RECORD  
28 DEC 1999 3:56:09 PM  
BARBARA MORRISON  
REGISTER OF DEEDS  
MENOMINEE, MI 49858

Register of Deeds Stamp & File Number

4. Lot No. \_\_\_\_\_, Recorded Plat \_\_\_\_\_  
5. Private Claims \_\_\_\_\_

I, William Lenca, in a field survey on Nov., 19 99 do hereby state that under requirements of P.A. 74, Michigan P.A. of 1970, the corner points mentioned in lines 1 and 2 above were in conformance with regulations and rules therefore as required in the current manual of survey instructions of the United States Department of the Interior, Bureau of Land Management or by a decree of a Court of Law and /or that the corner points mentioned in lines 3, 4 and 5 above were in conformance with the rules of the Michigan Board of Land Surveyors or by a Decree of a Court of Law; established, re-established, monumented, recovered, found as expressed below:

NOTE: Not more than 2 corners, all in the same town and range, may be recorded on this certificate.


	A	B	C	D	E	F	G	H	I	J	K	L	M
1													
2	6		5		4		3		2		1		
3													
4	7		8		9		10		11		12		
5													
6	18		17		16		15		14		13		
7													
8	19		20		21		22		23		24		
9													
10	30		29		28		27		26		25		
11													
12	31		32		33		34		35		36		
13													

A. Description of original monument and accessories and/or subsequent restoration:

- 1848: Sectional Subdivision by James H. Mullett - B.T.'s - Sugar, 12" - N58°W - 24 lks., Sugar, 15" - S45°E - 11 lks. All original evidence for this corner has been destroyed by county road improvements.
- 1900: Subd. of Section 24, T35N-R27W by Albert Hass states "Corner formerly set, nothing near". Distances shown to other corners in Section 24.
- 1990: L.C.R.C. No. 890, Bk 3, by William Lenca, RLS No. 26461 - Found 1/2" dia. Iron Rod set by George B. Wilson, RLS 17607, in center of E - W Co. Rd and in line with ancient fences N - S. TIES: 1/2" dia. Iron Rod - N54°E - 55.25'; 1/2" dia. Iron Rod - S52°E - 38.38'; Basswood, 10" - S57°W - 27.15'; FN W-5298 Sign Post - N19°W - 32.97'.

B. Description of corner evidence found and/or method applied in restoring or reestablishing corner:

We found a 1/2 inch diameter iron rod in the centerline of an East - West County Road and in line with ancient fences running North and South, along with the ties described in part "A" above. The distance from this corner to the 1/4 Corner to the East is 2651.30 feet compared to Alber Hass's record distance of 2650.56 feet. This corner position matches well with old surveys and long standing lines of occupation, and is accepted as the best available evidence of the position of the original corner.

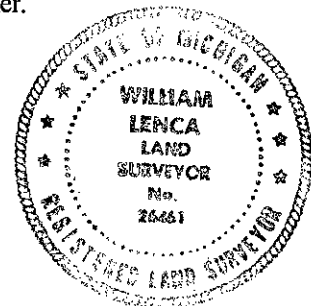

C. Description of monument for corner and accessories established to perpetuate locating the position of the corner:

Set 5/8" x 24" Iron Rod/3-1/4" dia. Alum. cap stamped for corner location in Monument Box:

5/8" x 24" Iron Rod/2" Alum. cap marked WITNESS MARKER	South	22.85 feet	@ sign post
12" dia. Basswood	S 57° W	27.10 feet	Scr. NBT
5/8" x 24" Iron Rod/2" Alum. cap marked WITNESS MARKER	N 12° W	32.95 feet	1 ft. W. of tel. box
Nothing else nearby			
Metal Survey Sign Post	South	23.35 feet	

NOTE: All bearings are magnetic bearings. All distances are measured with steel tape. Distances to trees are to nail in side of tree.

Signed by William Lenca  
Surveyor's Michigan License No. 26461

Date Nov. 23, 1999