SURVEY & REMONUMENTATION

APR 06 1999

SECTION

Approved by Menominee County
Land Survey Remonumentation
Peer Group Under Act 345 Of
PA ~~Of~~ 1990 On 10/29, 1998
Terrence J. Warin P.S.
Chairman

LAND CORNER RECORDATION CERTIFICATE
Filing Requirement of Act 74, Mich. P.A. 1970

RECEIVED FOR RECORD
98 DEC 14 PM 3:20
PAGE # 656 BK 5
BARBARA MORRISON
REGISTER OF DEEDS
MENOMINEE, MI 49858

Register of Deeds Stamp & File Number

For corners in

MENOMINEE (County)

	Located In:	Corner Code #
1. Public Land Survey	T34N R 27W	L-01
	T___ R___	
	T___ R___	
	T___ R___	
2. Property Controlling	S___ T___ R___	
in Section	S___ T___ R___	
3. Miscellaneous	S___ T___ R___	
Property in Sec.	S___ T___ R___	

4. Lot No. _____, Recorded Plat _____
5. Private Claims _____

(SAME AS CORNER L-13, T35N - R27W)

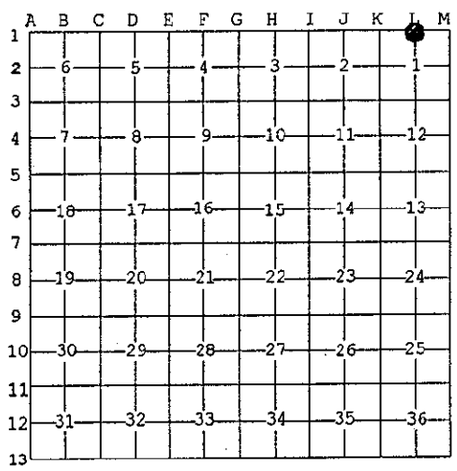

I, William Lenca, in a field survey on June 29, 19 98 do hereby state that under requirements of P.A. 74, Michigan P.A. of 1970, the corner points mentioned in lines 1 and 2 above were in conformance with regulations and rules therefore as required in the current manual of survey instructions of the United States Department of the Interior, Bureau of Land Management or by a decree of a Court of Law and /or that the corner points mentioned in lines 3, 4 and 5 above were in conformance with the rules of the Michigan Board of Land Surveyors or by a Decree of a Court of Law; established, re-established, monumented, recovered, found as expressed below:

NOTE: Not more than 2 corners, all in the same town and range, may be recorded on this certificate.

A. Description of original monument and accessories and/or subsequent restoration:

1847: Original Survey by H. Floyd - B.T.'s - Sugar, 12" - N45°E - 32 lks.; Cedar, 20" - N80°W - 14 lks. All original evidence for this corner has been destroyed by county road improvements.

B. Description of corner evidence found and/or method applied in restoring or reestablishing corner:

We found a railroad spike in the centerline of county roads East - West - North and at a position very nearly midway between the Section Corners 1/2 mile East and 1/2 mile West. This position has been used in other surveys, and is accepted as the best available evidence of the position of the original corner.

STATE OF MICHIGAN
WILLIAM LENCA
LAND SURVEYOR
No. 26461
REGISTERED LAND SURVEYOR

C. Description of monument for corner and accessories established to perpetuate locating the position of the corner:

Set 5/8" x 24" Iron Rod/3-1/4" dia. Alum. cap stamped for corner location in Monument Box:

5/8" x 24" Iron Rod/2" dia. Alum. cap marked "WITNESS MARKER"	N45°E	48.48 feet	1' S.W. of P.P.
5/8" x 24" Iron Rod/2" dia. Alum. cap marked "WITNESS MARKER"	S51°E	46.18 feet	1' S.W. of P.P.
5" dia. White Ash	S68°W	96.53 feet	Scr. NBT
10" dia. White Ash	N45°W	63.83 feet	Scr. NBT
Metal Survey Sign Post	N47°E	51.1 feet	

NOTE: All bearings are magnetic bearings. All distances are measured with steel tape. Distances to trees are to nail in side of tree.

Signed by William Lenca Date Oct. 21, 1998

Surveyor's Michigan License No. 26461

FORM APPROVED BY MICHIGAN STATE BOARD OF PROFESSIONAL SURVEYORS, JAN. 28, 1971
REVISED MAY 14,1975
REVISED JAN., 1983
REVISED OCT., 1995