SURVEY & REMONUMENTATION

MAR 29 2000

SECTION

Approved by Menominee County Land Survey Remonumentation Peer Group Under Act 345 Of P.A. Of 1990 On 12/28, 1999
Mel Davis RLS
Chairman

LAND CORNER RECORDATION CERTIFICATE
Filing Requirement of Act 74, Mich. P.A. 1970

For corners in

MENOMINEE (County)

	Located In:	Corner Code #
1. Public Land Survey	T 35N R 27W	M-5
	T___ R___	
	T___ R___	
	T___ R___	
2. Property Controlling in Section	S___ T___ R___	
	S___ T___ R___	
3. Miscellaneous Property in Sec.	S___ T___ R___	
	S___ T___ R___	

Bk. 6 Pg. 87

RECEIVED FOR RECORD
28 DEC 1999 3:56:09 PM
BARBARA MORRISON
REGISTER OF DEEDS
MENOMINEE, MI 49858

Register of Deeds Stamp & File Number

4. Lot No. _____ , Recorded Plat _____
5. Private Claims _____

SAME AS CORNER A-5, T35N-R26W

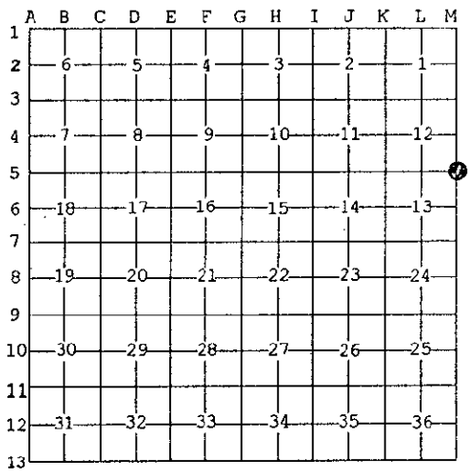

I, William Lenca, in a field survey on Nov. ', 19 99 do hereby state that under requirements of P.A. 74, Michigan P.A. of 1970, the corner points mentioned in lines 1 and 2 above were in conformance with regulations and rules therefore as required in the current manual of survey instructions of the United States Department of the Interior, Bureau of Land Management or by a decree of a Court of Law and /or that the corner points mentioned in lines 3, 4 and 5 above were in conformance with the rules of the Michigan Board of Land Surveyors or by a Decree of a Court of Law; established, re-established, monumented, recovered, found as expressed below:

NOTE: Not more than 2 corners, all in the same town and range, may be recorded on this certificate.

A. Description of original monument and accessories and/or subsequent restoration:

1847: Twp. Boundary by H. Floyd - B.T.'s - Lynn, 10" - S68°W - 25 lks; Lynn, 36" - N47°W - 25 lks
1848: Sectional Subdivision by James H. Mullett - B.T.'s - Sugar, 8" - S46°E - 13 lks.; Sugar, 12" - N78°E - 38 lks. All original evidence for this corner has been destroyed by land clearing and farming activities.

B. Description of corner evidence found and/or method applied in restoring or reestablishing corner:

We set this corner at an ancient fence corner - fences run North - South and West from this position. This position fits well with the 1/16 fence line 1/4 mile South, is consitent with long standing lines of occupation and is accepted as the best available evidence of the position of the original corner.

C. Description of monument for corner and accessories established to perpetuate locating the position of the corner:

Set 3/4" dia. x 4' long aluminum rod/3-1/4" dia. Alum. cap stamped for corner.

20" dia. Elm	North	38.05 feet	Scr. NBT
6" dia. Maple	S 5° E	40.78 feet	Scr. NBT
24" dia. Elm	West	1.75 feet	Scr. NBT
Nothing else nearby			
Metal Survey Sign Post	East	3.50 feet	

STATE OF MICHIGAN WILLIAM LENCA LAND SURVEYOR No. 26461 REGISTERED LAND SURVEYOR

NOTE: All bearings are magnetic bearings. All distances are measured with steel tape. Distances to trees are to nail in side of tree.

Signed by William Lenca Date Nov. 23, 1999

Surveyor's Michigan License No. 26461

FORM APPROVED BY MICHIGAN STATE BOARD OF PROFESSIONAL SURVEYORS, JAN. 28, 1971
REVISED MAY 14,1975
REVISED JAN., 1983
REVISED OCT., 1995