

APR 06 1999

LAND CORNER RECORDATION CERTIFICATE
Filing Requirement of Act 74, Mich. P.A. 1970

RECEIVED FOR RECORD
1992 JUN 17 AM 11:37

SECTION

For corners in

Menominee (County)	Located In:	Corner Code ==
1. Public Land Survey	T 35N R 28W	<u>E-1</u> F-1
	T _____ R _____	_____
	T _____ R _____	_____
	T _____ R _____	_____
2. Property Controlling in Section	S _____ T _____ R _____	_____
	S _____ T _____ R _____	_____
3. Miscellaneous Property in Sec.	S _____ T _____ R _____	_____
	S _____ T _____ R _____	_____

PAGE # 436-RK
HENRY GUROSH
REGISTER OF DEEDS
MENOMINEE, MI 49858

Register of Deeds Stamp & File Number

4. Lot No. _____, Recorded Plat _____
5. Private Claims _____

	A	B	C	D	E	F	G	H	I	J	K	L	M
2	6		5		4		3		2		1		
3													
4	7		8		9		10		11		12		
5													
6	18		17		16		15		14		13		
7													
8	19		20		21		22		23		24		
9													
10	30		29		28		27		26		25		
11													
12	31		32		33		34		35		36		
13													

SAME AS CORNER F-13 T36N-R28W
SAME AS CORNER E-13 T36N-R28W

I, Paul R. Bressette, in a field survey on May 18, 19 92, do hereby certify that under requirements of P.A. 74, Michigan P.A. of 1970, the corner points mentioned in lines 1 and 2 above were in conformance with regulations and rules therefore as required in the current manual of survey instructions of the United States Department of the Interior, Bureau of Land Management or by a decree of a Court of Law and/or that the corner points mentioned in lines 3, 4 and 5 above were in conformance with the rules of the Michigan Board of Land Surveyors or by a Decree of a Court of Law; established, re-established, monumented, re-monumented, recovered, found as expressed below:


NOTE: Not more than 4 corners, all in the same town and range, may be recorded on this certificate.

A. Description of original monument and accessories and/or subsequent restoration:

- 1. Section Corner common to Sections 4, 5, 32 and 33. Restored in 1958 by Billy Buckler, RLS. Set 1" iron pipe with 4" brass cap witnessed by: 24" W. Pine S 11° E 189½ links and a 36" W. Pine N 26° E 225 links.
- 1. Quarter Corner common to Sections 4 and 33. Restored in 1958 by Billy Buckler, RLS. Set 1" iron pipe with 4" brass cap witnessed by: 10" W. Pine N 13° E 93½ links and a 9" Elm S 53° W 165 links.

B. Description of corner evidence found and/or method applied in restoring or reestablishing corner:

- 1. Found monument and witnesses as described. Monument was found to be approx. 20' south of proper position. Reset monument in proper location from witnesses. SW BT is dead but still standing. Corner falls on easterly edge of power line clearing.
- 1. Found 1958 witnesses as described, no evidence of monument. Set new monument from witnesses NE BT has been cut, but measuring notch is still visible on stump. Corner falls in small clearing and a fence line runs north, beginning about 75 feet from corner.

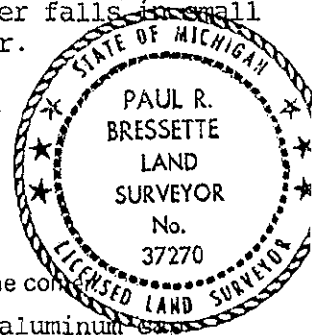

C. Description of monument for corner and accessories established to perpetuate locating the position of the corner:

- | | |
|--|--|
| 1. 1" iron pipe with 4" brass cap | E-1. 1" iron pipe with 4" aluminum cap |
| *14" White Pine (¼S,NBT) N 14° E 61.7' | *36" Pine stump (notch) N 29° E 148. |
| 7" Red Maple (¼S,NBT) S 78° E 38.5' | 10" Red Maple (S33,NBT) N 70° E 94. |
| Power Pole (nail) S 02° E 115.1' | *36" White Pine (S4,NBT) S 14° E 125. |
| *9" Dead Elm (¼S,NBT) S 55° W 108.9' | 12" Cherry (S5,NBT) S 43° W 57. |
| 6" Red Maple (¼S,NBT) N 24° W 31.35' | 4" Cherry (S32,NBT) N 07° W 64.5 |
| * old NBT's (1958) | * old NBT's (1958) |

Signed by Paul R. Bressette Date 6-17-92
Surveyor's Michigan License No. 37270