SURVEY & REMONUMENTATION

MAR 29 2000

SECTION

Approved by Menominee County Land Survey Remonumentation Peer Group Under Act 345 Of P.A. Of 1990 On 12/09 1999

Chairman

LAND CORNER RECORDATION CERTIFICATE
Filing Requirement of Act 74, Mich. P.A. 1970

Bk. 6 Pg. 63

RECEIVED FOR RECORD
28 DEC 1999 3:56:09 PM
BARBARA MORRISON
REGISTER OF DEEDS
MENOMINEE, MI 49858

Register of Deeds Stamp & File Number

For corners in MENOMINEE (County)

	Located In:	Corner Code #
1. Public Land Survey	T 35N R 28W	G-10
	T___ R___	
	T___ R___	
	T___ R___	
2. Property Controlling in Section	S___ T___ R___	
	S___ T___ R___	
3. Miscellaneous Property in Sec.	S___ T___ R___	
	S___ T___ R___	

4. Lot No. _____, Recorded Plat _____
5. Private Claims _____

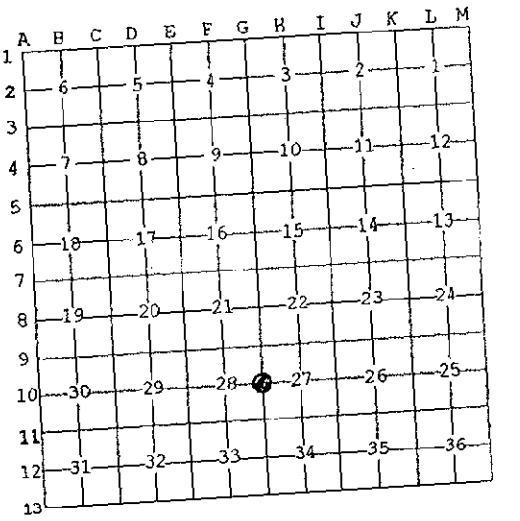

I, William Lenca, in a field survey on Aug., 19 99 do hereby state that under requirements of P.A. 74, Michigan P.A. of 1970, the corner points mentioned in lines 1 and 2 above were in conformance with regulations and rules therefore as required in the current manual of survey instructions of the United States Department of the Interior, Bureau of Land Management or by a decree of a Court of Law and /or that the corner points mentioned in lines 3, 4 and 5 above were in conformance with the rules of the Michigan Board of Land Surveyors or by a Decree of a Court of Law; established, re-established, monumented, recovered, found as expressed below:

NOTE: Not more than 2 corners, all in the same town and range, may be recorded on this certificate.

A. Description of original monument and accessories and/or subsequent restoration:

1852: Original Survey by Francis Coleman - B.T.'s - Cedar, 14" - N25°W - 07 lks.; Cedar, 8" - S31°E - 21 lks. All original evidence for this corner has been destroyed by logging activities.

1991: L.C.R.C. Number 909 by William Lenca states, "Set corner midway and on line between section corners. This position fits well with GLO Terrain call (edge of swamp 409' south) and with remains of 30" White Pine Stump (line tree) 9.7 chains south." Set 3/4" x 60" Alum. Rod/3-1/2" dia. Alum. cap marked MENOMINEE COUNTY SURVEY MARKER. TIES: Cedar, 5" - S80°W - 2.19'; Cedar, 5" - N10°W - 18.90'; Black Spruce, 8" - S75°E - 8.32'; Cedar, 3" - S25°E - 3.42'; Carsonite - N65°E - 2.00'.

B. Description of corner evidence found and/or method applied in restoring or reestablishing corner:

We recovered a 3/4 inch diameter aluminum rod with a 3-1/4 inch diameter cap stamped for corner location. This corner was found in a position which did not fit with the single proportional location. We adjusted the corner monument to be on line and midway between the NE and SE Corners of Section 28, T35N-R28W, and accepted this location as a careful and faithful reestablishment of the position of the original corner.

C. Description of monument for corner and accessories established to perpetuate locating the position of the corner:

Re-set existing 3/4" x 5' long aluminum rod/3-1/4" dia. Alum. cap stamped for corner:

8" dia. Cedar	N63°E	26.53 feet	Scr. NBT
10" dia. Cedar	S22°W	22.91 feet	Scr. NBT
12" dia. White Pine	N83°W	26.36 feet	Scr. NBT
5" dia. Cedar	S46°E	29.00 feet	Scr. NBT
Carsonite Marker	South	0.4 feet	

STATE OF MICHIGAN WILLIAM LENCA LAND SURVEYOR No. 26461 REGISTERED LAND SURVEYOR

NOTE: All bearings are magnetic bearings. All distances are measured with steel tape. Distances to trees are to nail in side of tree.

Signed by _____ Date Dec. 9, 1999

Surveyor's Michigan License No. 26461

FORM APPROVED BY MICHIGAN STATE BOARD OF PROFESSIONAL SURVEYORS, JAN. 28, 1971
REVISED MAY 14, 1975
REVISED JAN., 1993
REVISED OCT., 1995